

UNITED STATES
DEPARTMENT OF THE INTERIOR
BUREAU OF LAND MANAGEMENT

R-6812
63039


SECTION 11

Oregon State Water Filings

SE 1/4 NE 1/4

TOWNSHIP 31S, RANGE 26E, W. M.

Tied in with aerial photos and O.S.H.D. Quad Maps

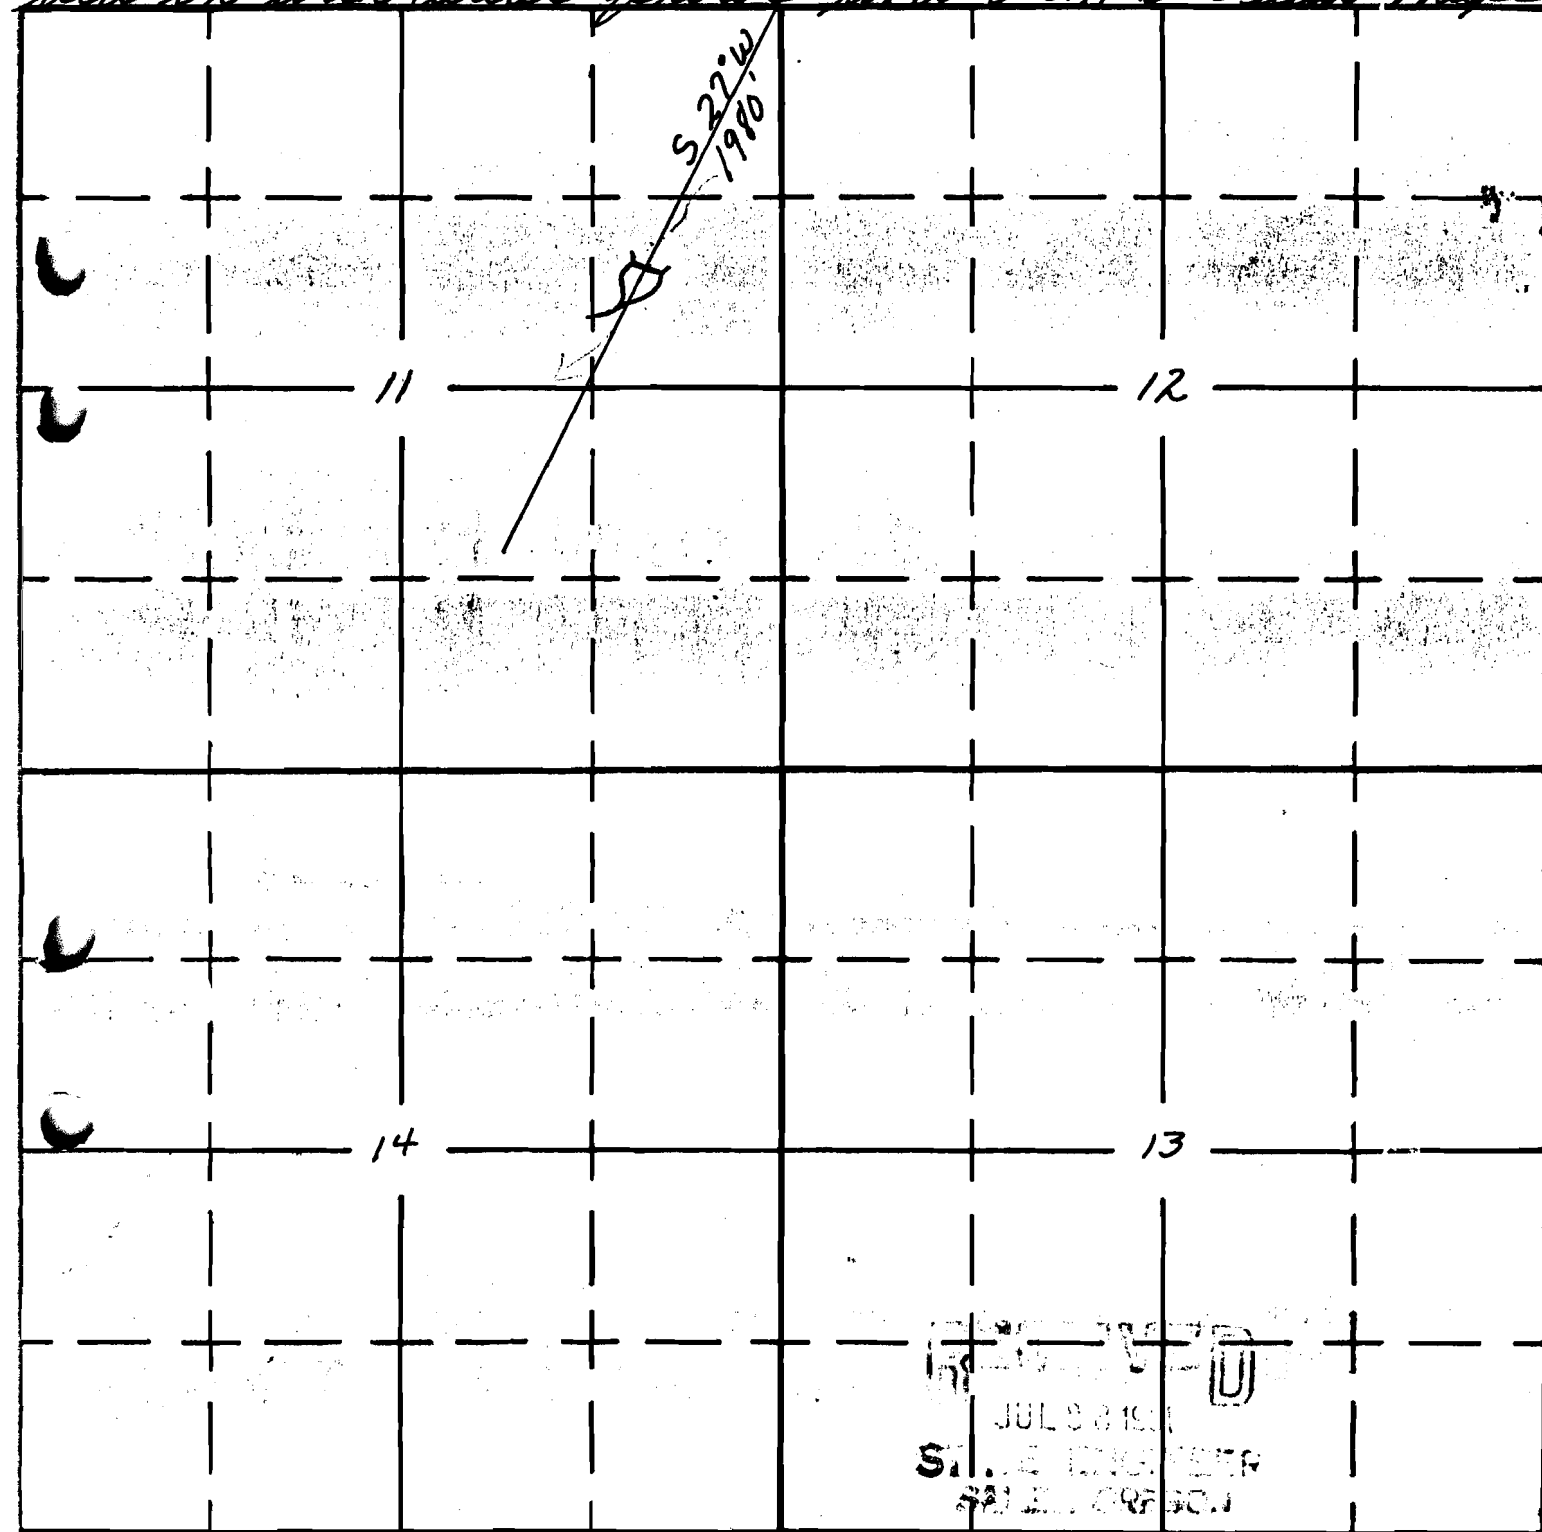

South

APPLICATION No. R-35735

PERMIT No. 11 5342

Form AI-187
March 1961

UNITED STATES
DEPARTMENT OF THE INTERIOR
BUREAU OF LAND MANAGEMENT

SECTION


SW $\frac{1}{4}$ SE $\frac{1}{4}$

SEC. 33

Oregon State Water Filings

TOWNSHIP 22 S, RANGE 27 E, W. M.

North

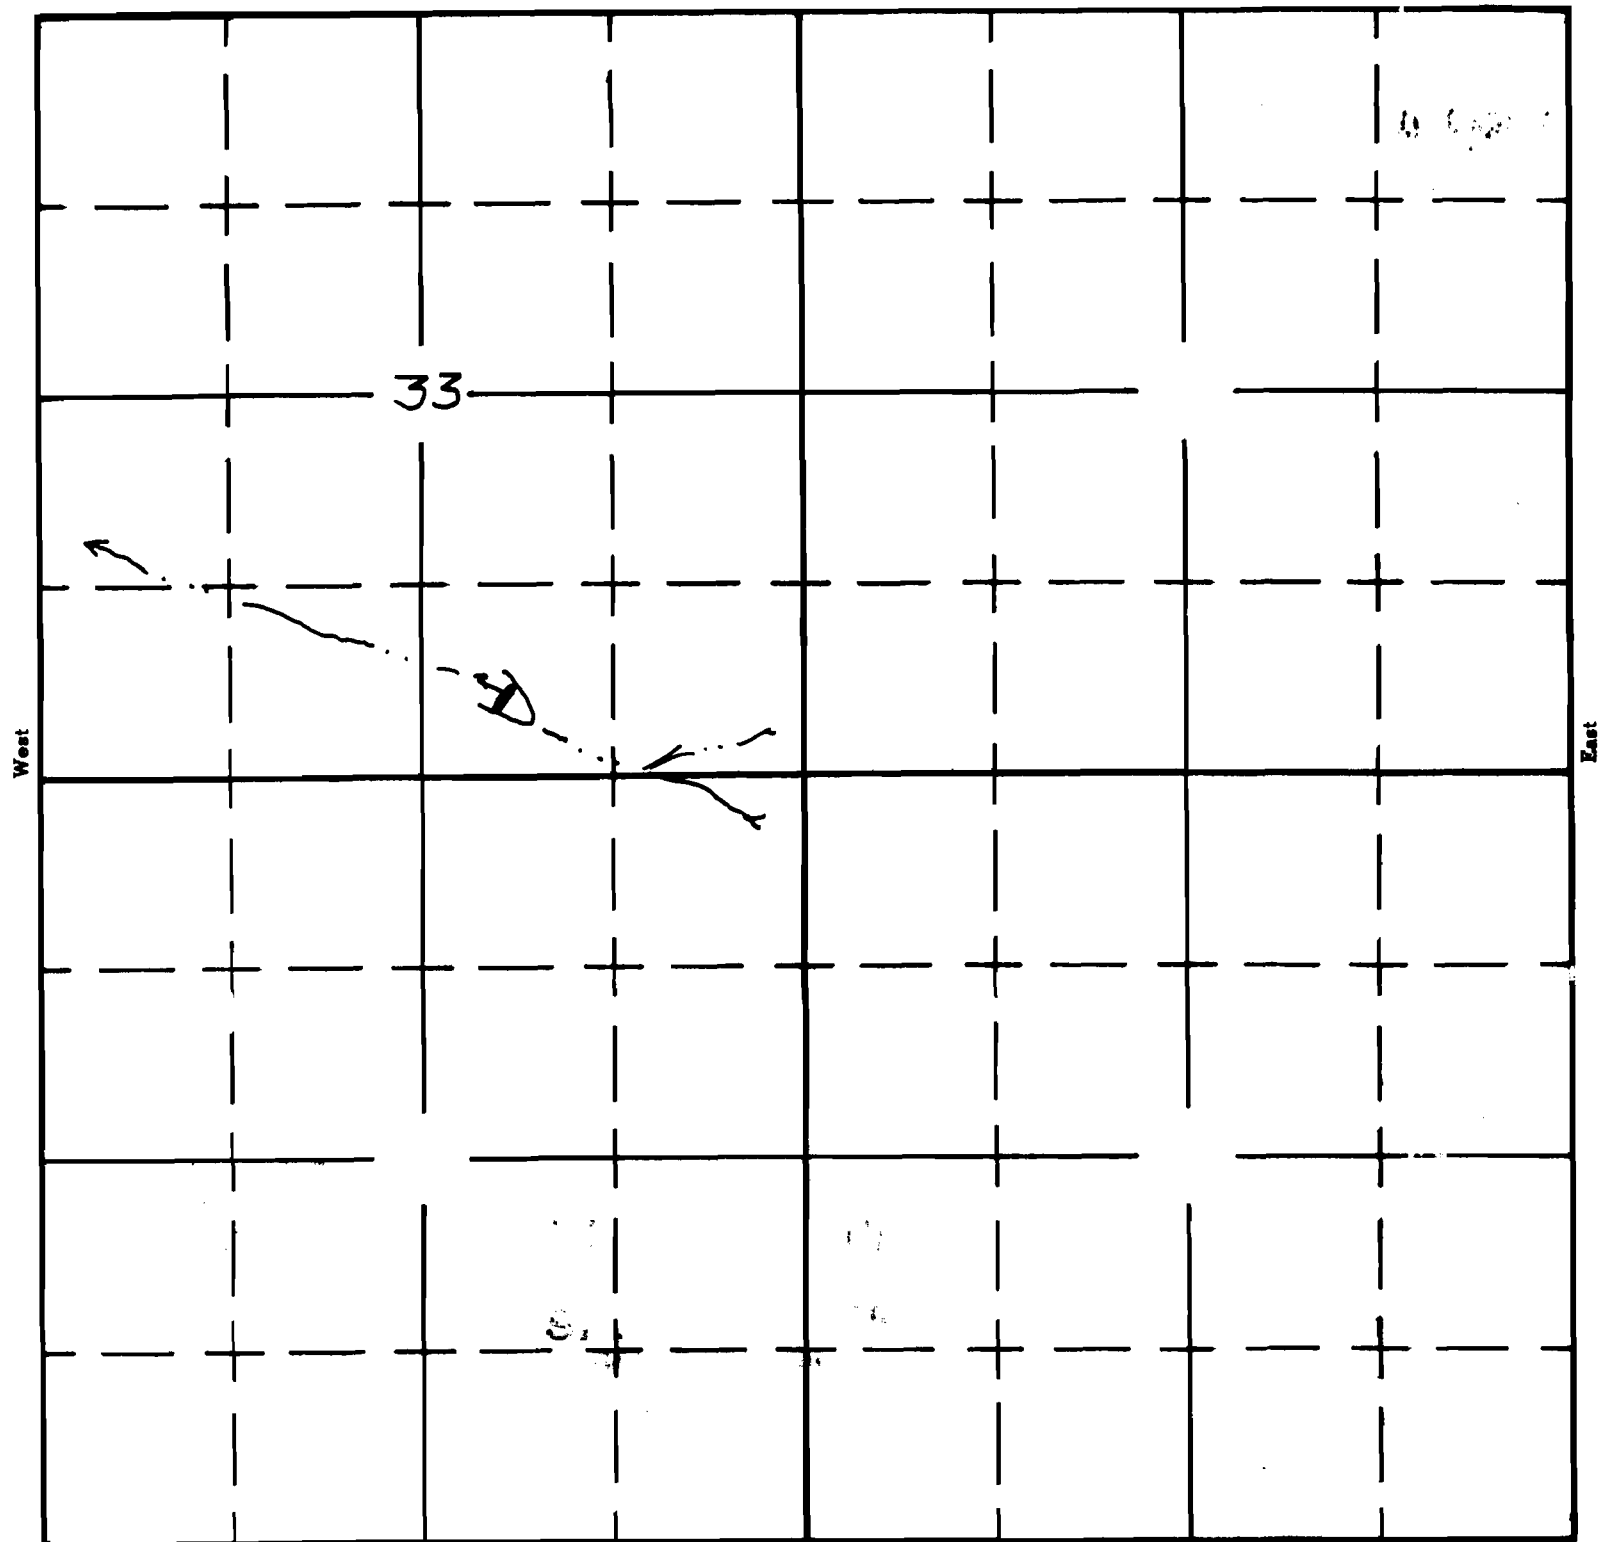

South

APPLICATION No. R-35650
PERMIT No. R 6812