

Form AI-187
March 1961

UNITED STATES
DEPARTMENT OF THE INTERIOR
BUREAU OF LAND MANAGEMENT

SECTION


NE $\frac{1}{4}$ SW $\frac{1}{4}$

SEC 24

Oregon State Water Filings

TOWNSHIP 26 S, RANGE 23 E, W. M.

North

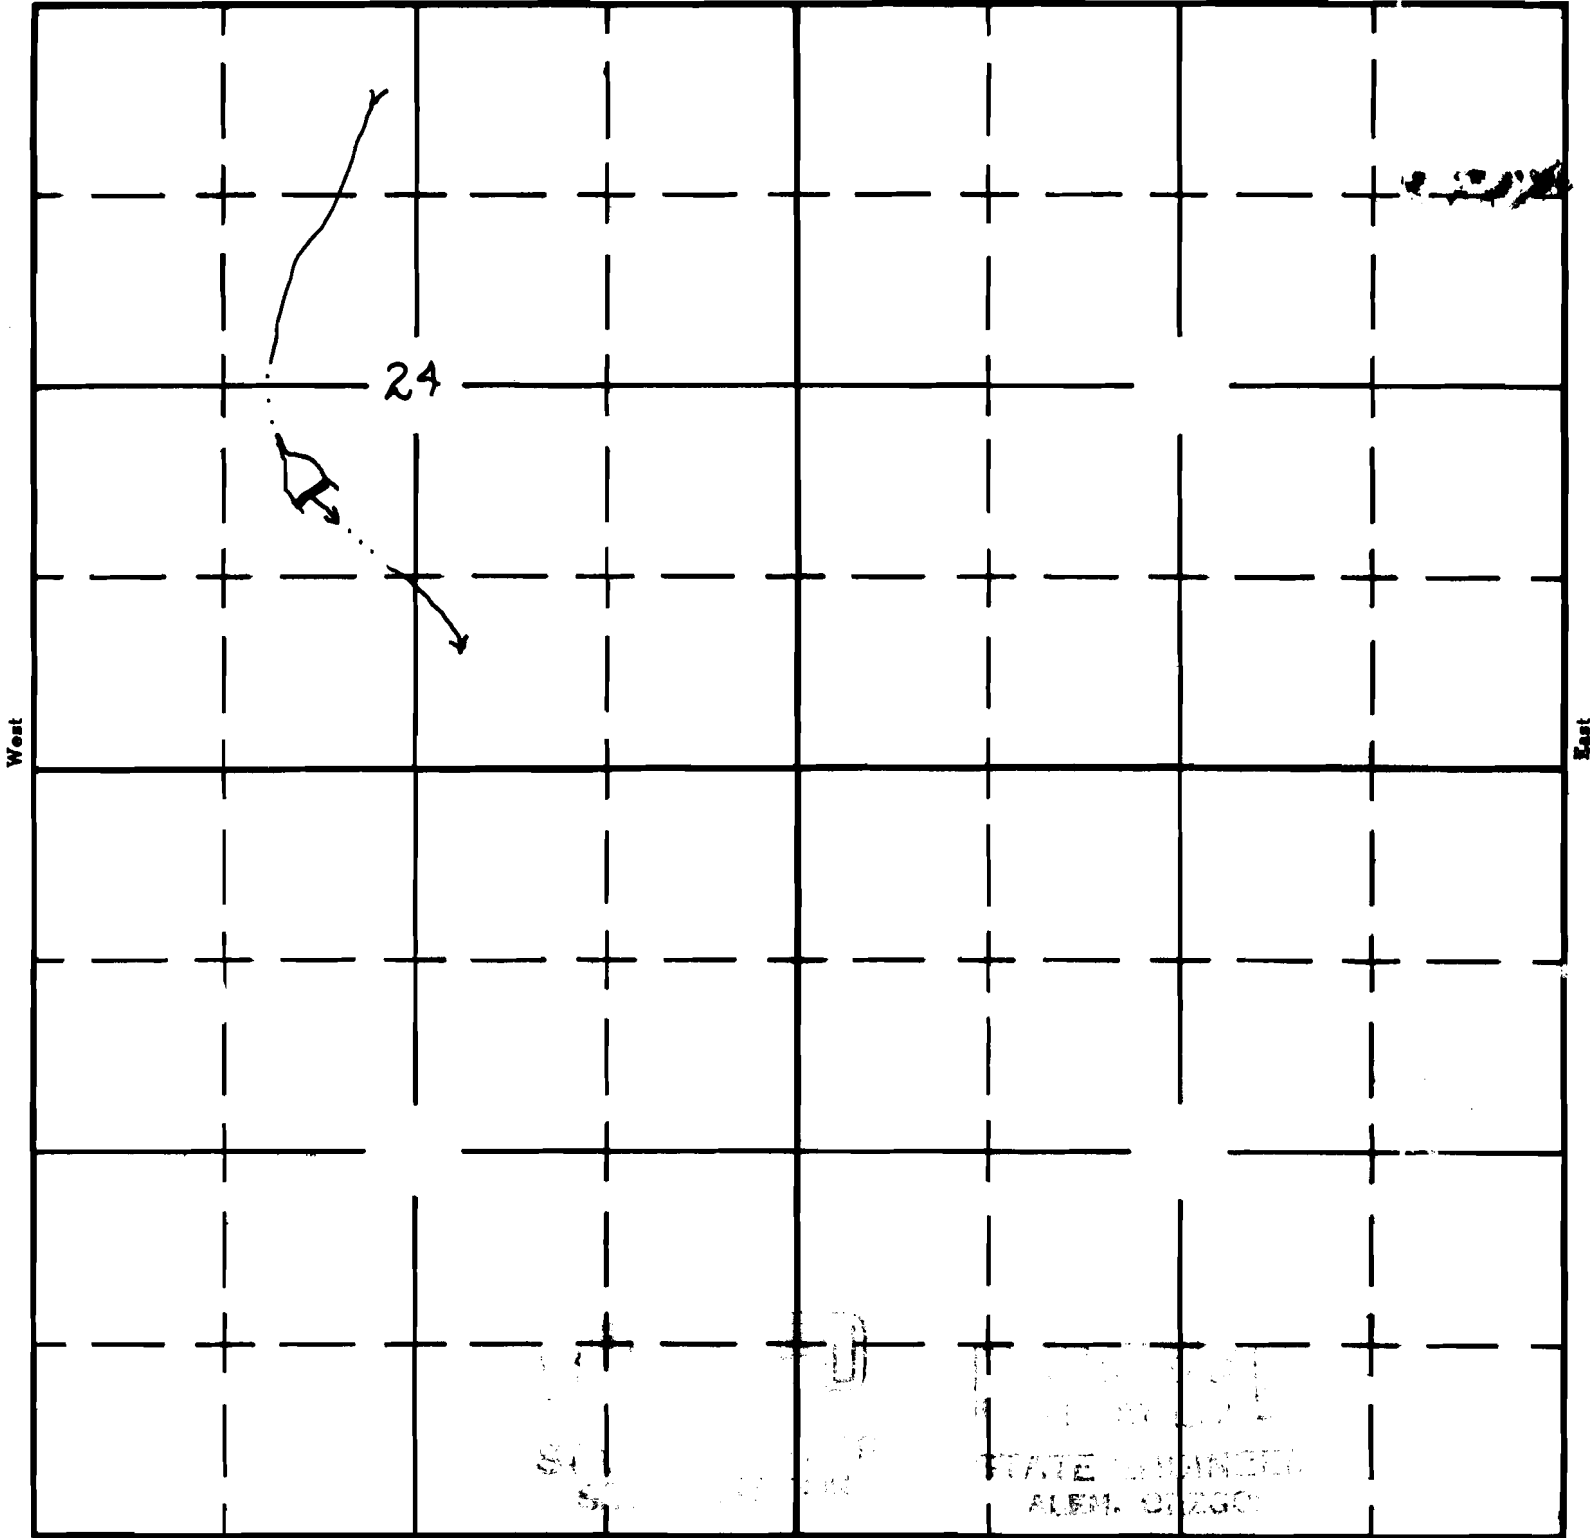

South

APPLICATION No. R-35666
PERMIT No. 15532