

R-6880
63043

Form AI-187
March 1961

UNITED STATES
DEPARTMENT OF THE INTERIOR
BUREAU OF LAND MANAGEMENT


SECTION 33

Oregon State Water Filings

SE 1/4 SE 1/4

TOWNSHIP 38 S, RANGE 26 E, W. M.

Tied in with aerial photos and O.S.H.D. Quad Maps.

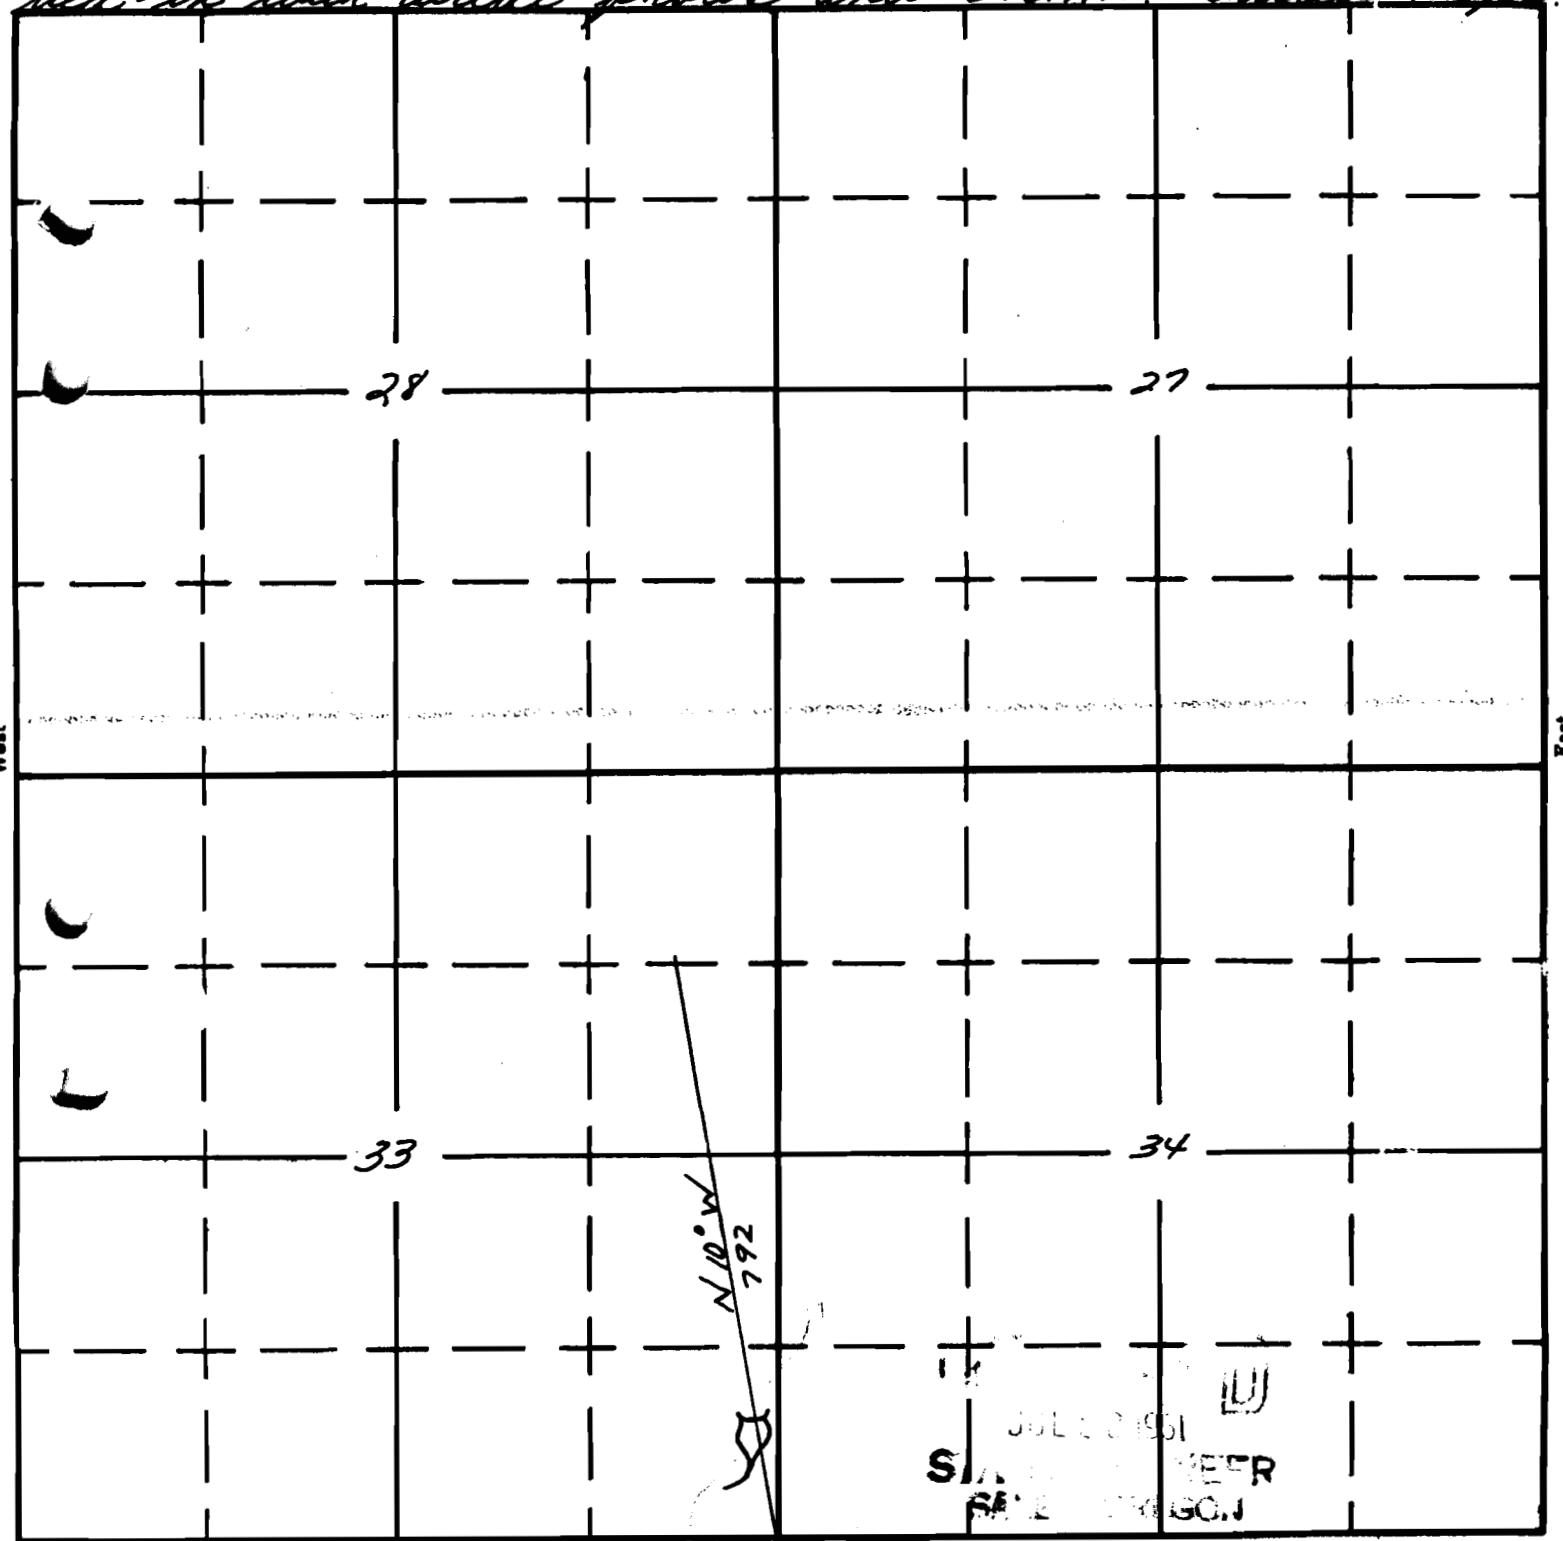

APPLICATION No. R-35792
PERMIT No. 1 **RRM**