

Form AI-187
March 1961

RECEIVED
JUL 24 1961

UNITED STATES
DEPARTMENT OF THE INTERIOR
BUREAU OF LAND MANAGEMENT

R-6881
63044

SECTION

10


STATE ENGINEER
SALVAGE SECTION

Oregon State Water Filings

TOWNSHIP 40-S, RANGE 14 1/2-E W. M.

North

E. Branch Lost Riv. & Mex.

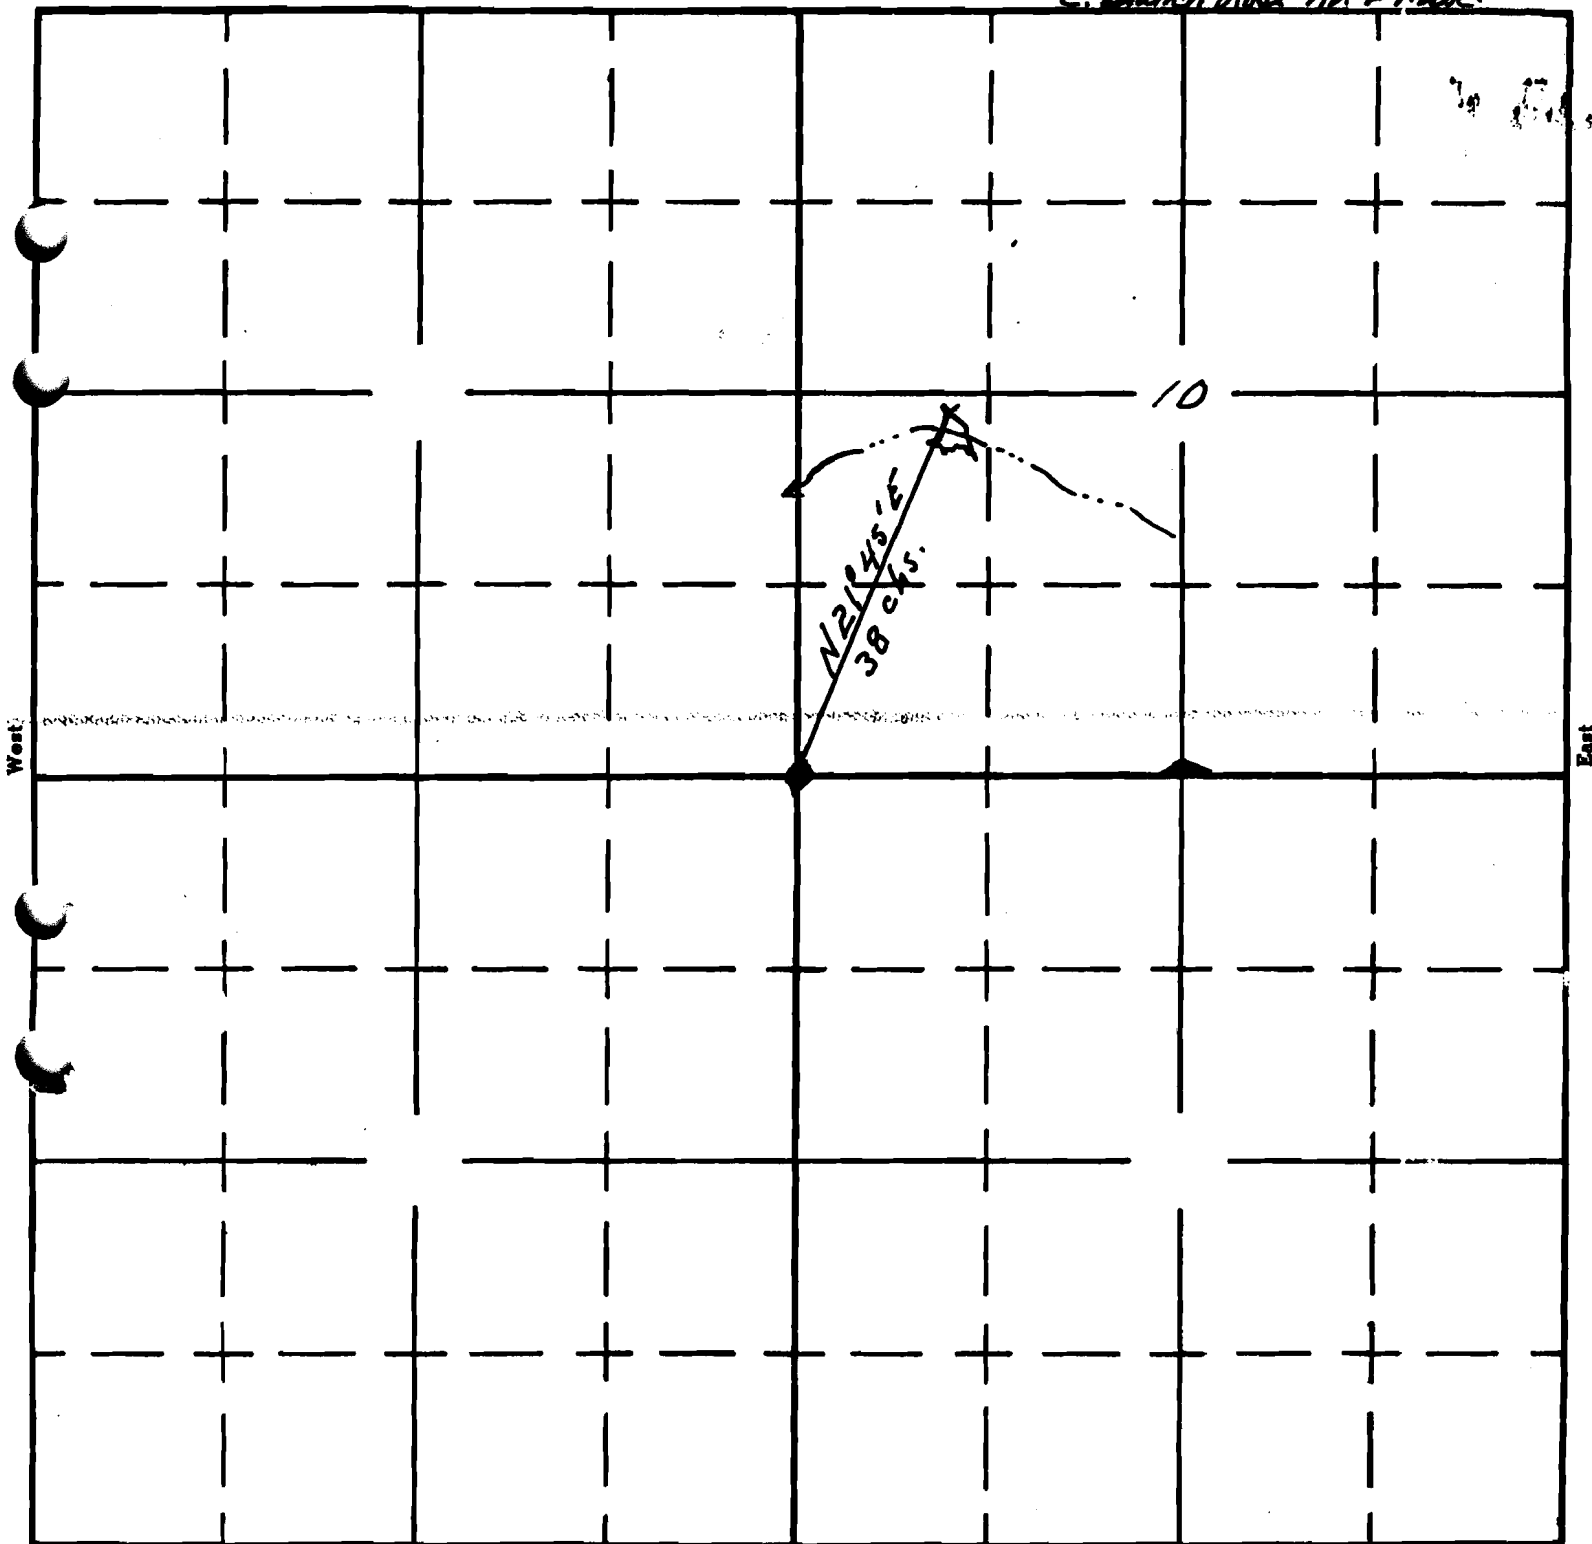

South

APPLICATION No. R-35232
PERMIT No. **6881**