

187
1961

UNITED STATES
DEPARTMENT OF THE INTERIOR
BUREAU OF LAND MANAGEMENT

R-6883
63045

SECTION

30

Oregon State Water Filings


NE 1/4
SE 1/4 SE 1/4

TOWNSHIP 36 S, RANGE 15 E, W. M.

North

Longue River Misc.

TIED-IN WITH AERIAL PHOTO
& QSHD. QUAD MAPS.

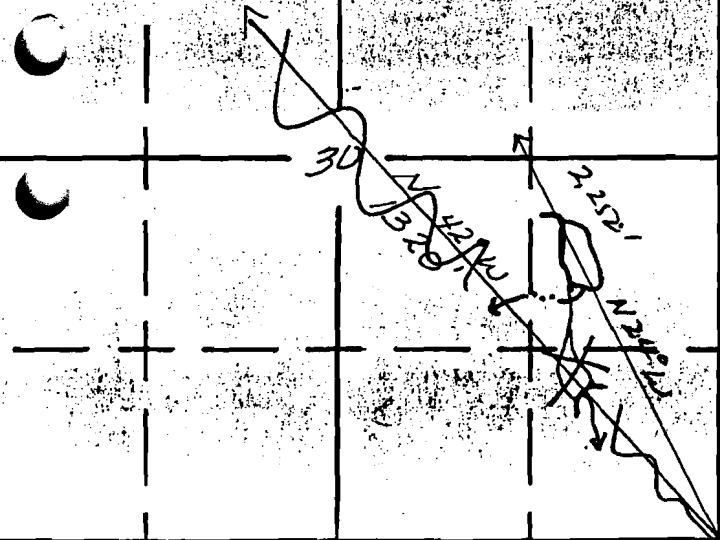

29
RECEIVED

APR 18 1983

WATER RESOURCES DEPT.
SALEM, OREGON

East

31

32

JUL 24 1981
STATE ENGINEER
SALEM, OREGON

South

APPLICATION No. R-35235
PERMIT No. R-6883