

Form A1-187  
March 1961

UNITED STATES  
DEPARTMENT OF THE INTERIOR  
BUREAU OF LAND MANAGEMENT

SECTION


SE 1/4 NE 1/4

SEC. 9

Oregon State Water Filings

TOWNSHIP 28 S, RANGE 27 E, W. M.

North

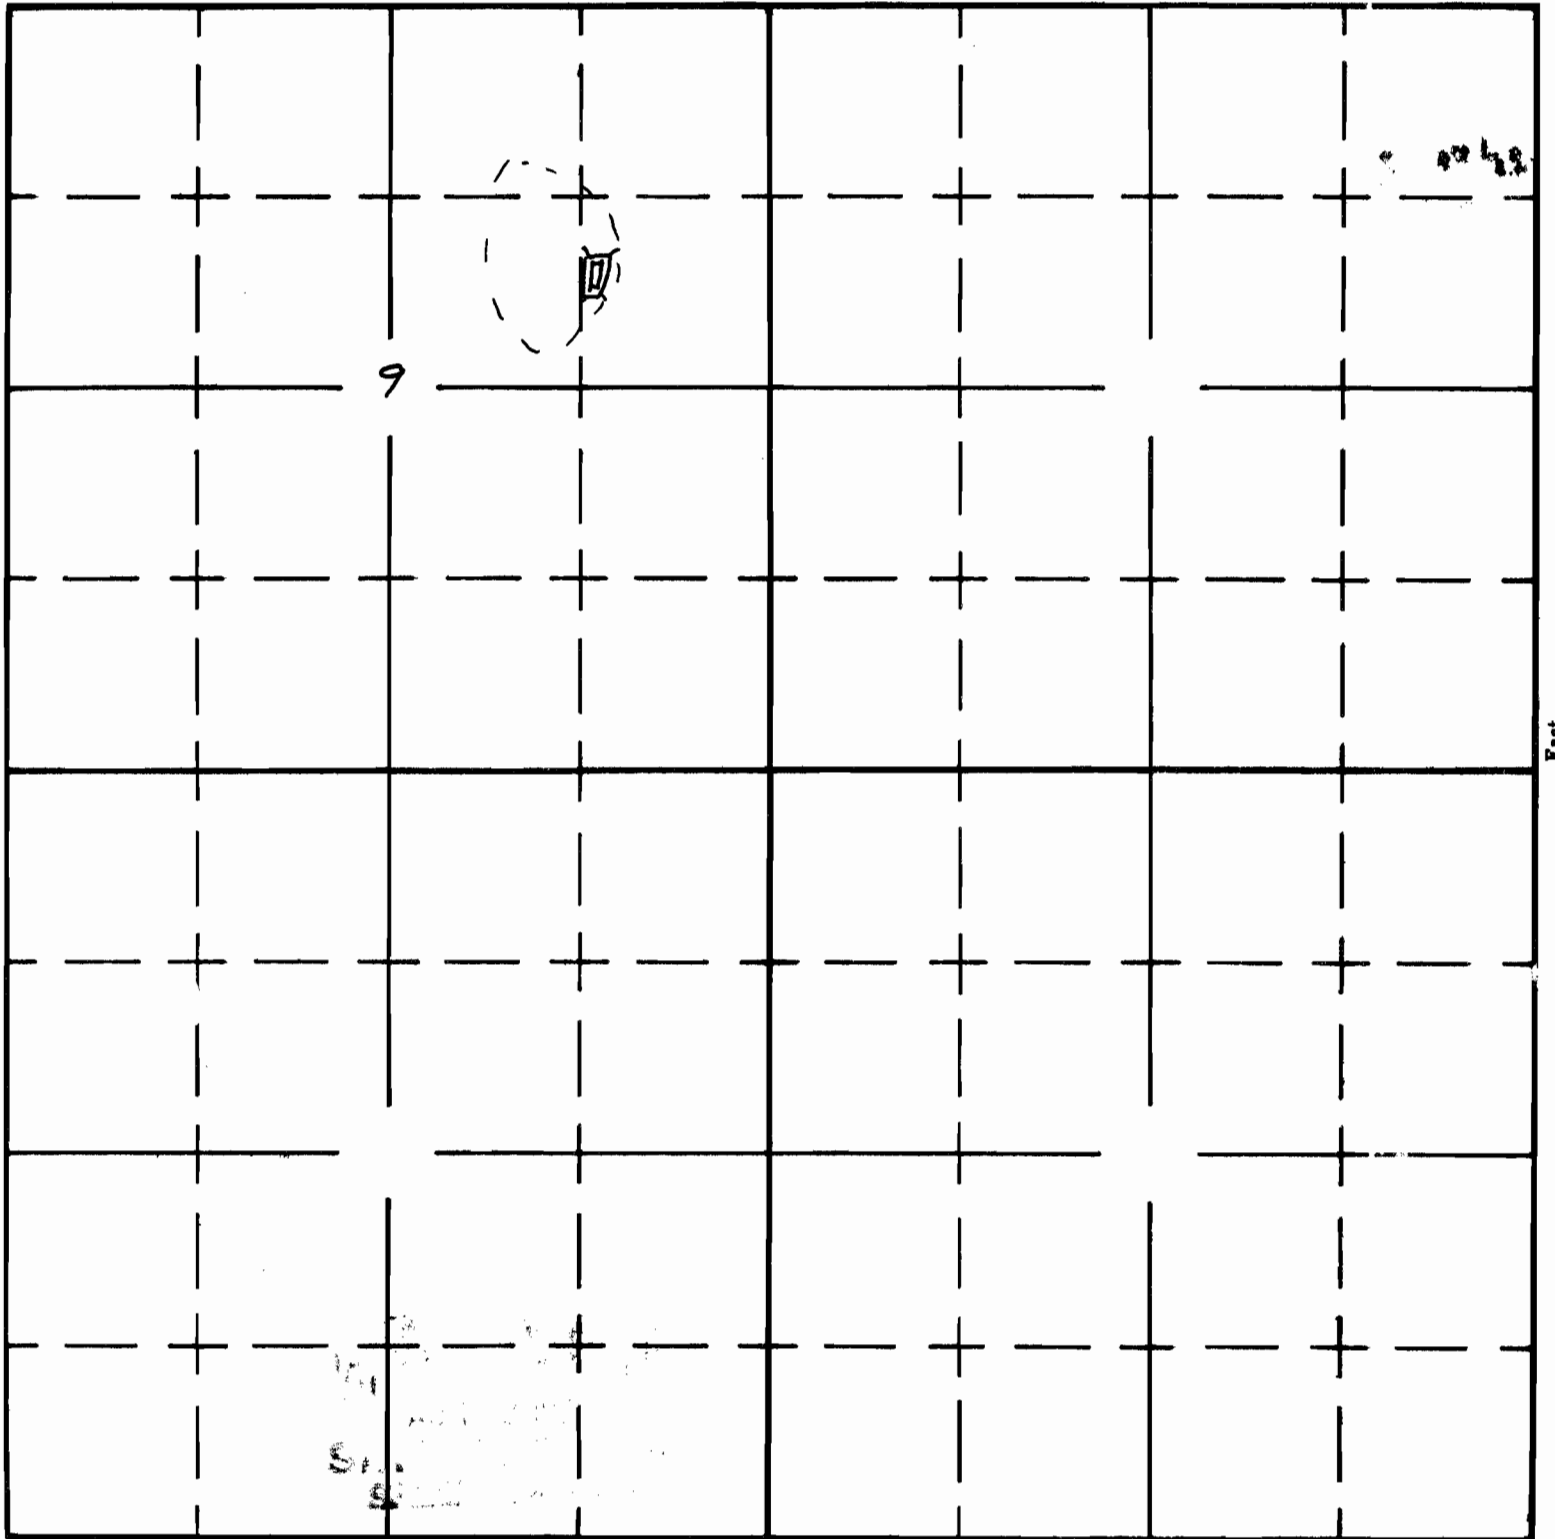

South

APPLICATION No. R-36028  
PERMIT No. R-36028