

Form AI-187
March 1961

UNITED STATES
DEPARTMENT OF THE INTERIOR
BUREAU OF LAND MANAGEMENT

SECTION


NE 1/4 SW 1/4

Oregon State Water Filings

SEC 19

TOWNSHIP 27S, RANGE 27E, W. M.

North

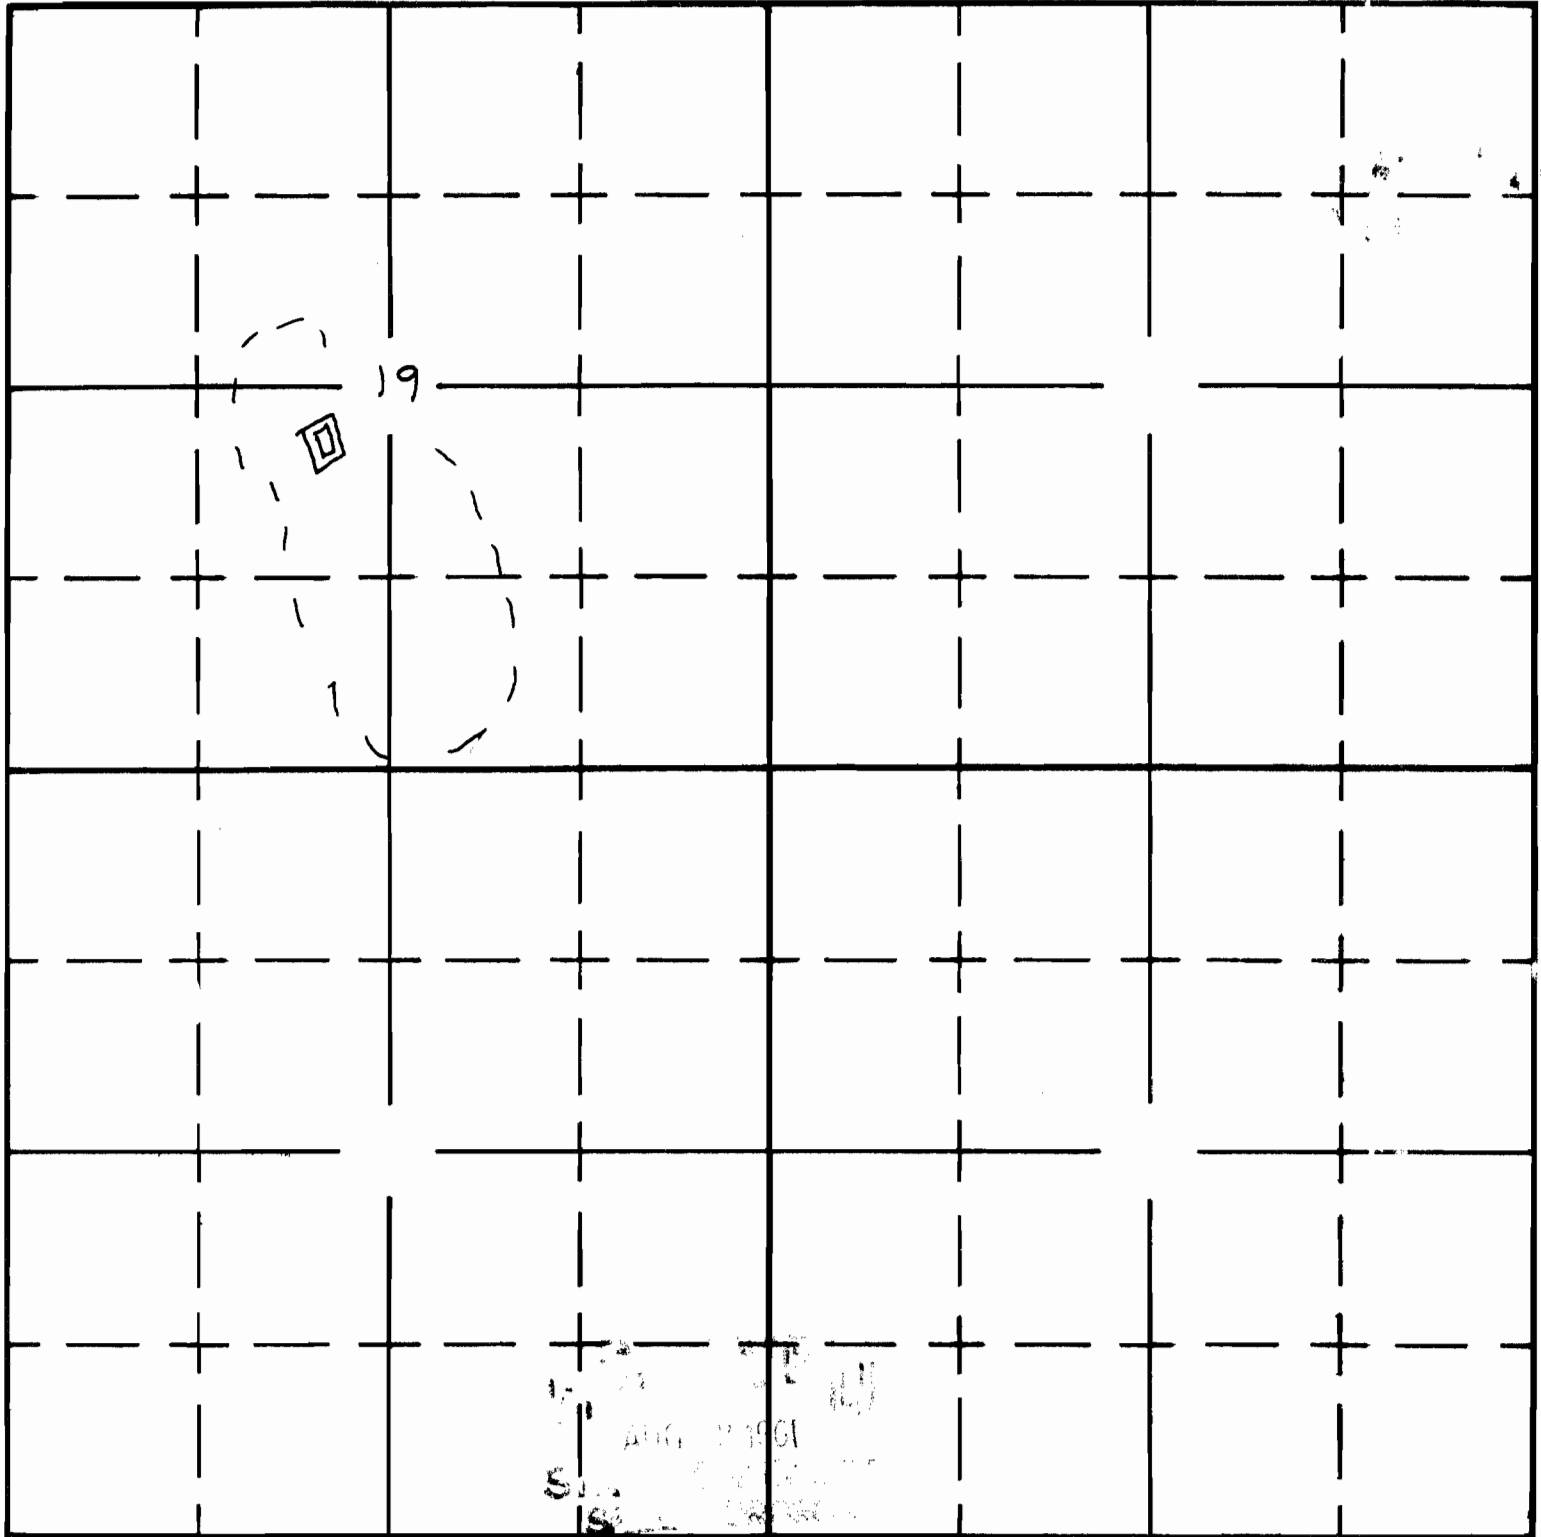

South

APPLICATION No. R-36031

PERMIT No. 8908