

UNITED STATES
DEPARTMENT OF THE INTERIOR
BUREAU OF LAND MANAGEMENT

SECTION


SW¹/₄ SW¹/₄

Oregon State Water Filings

SEC 35

TOWNSHIP 22 S, RANGE 24 E, W. M.

North

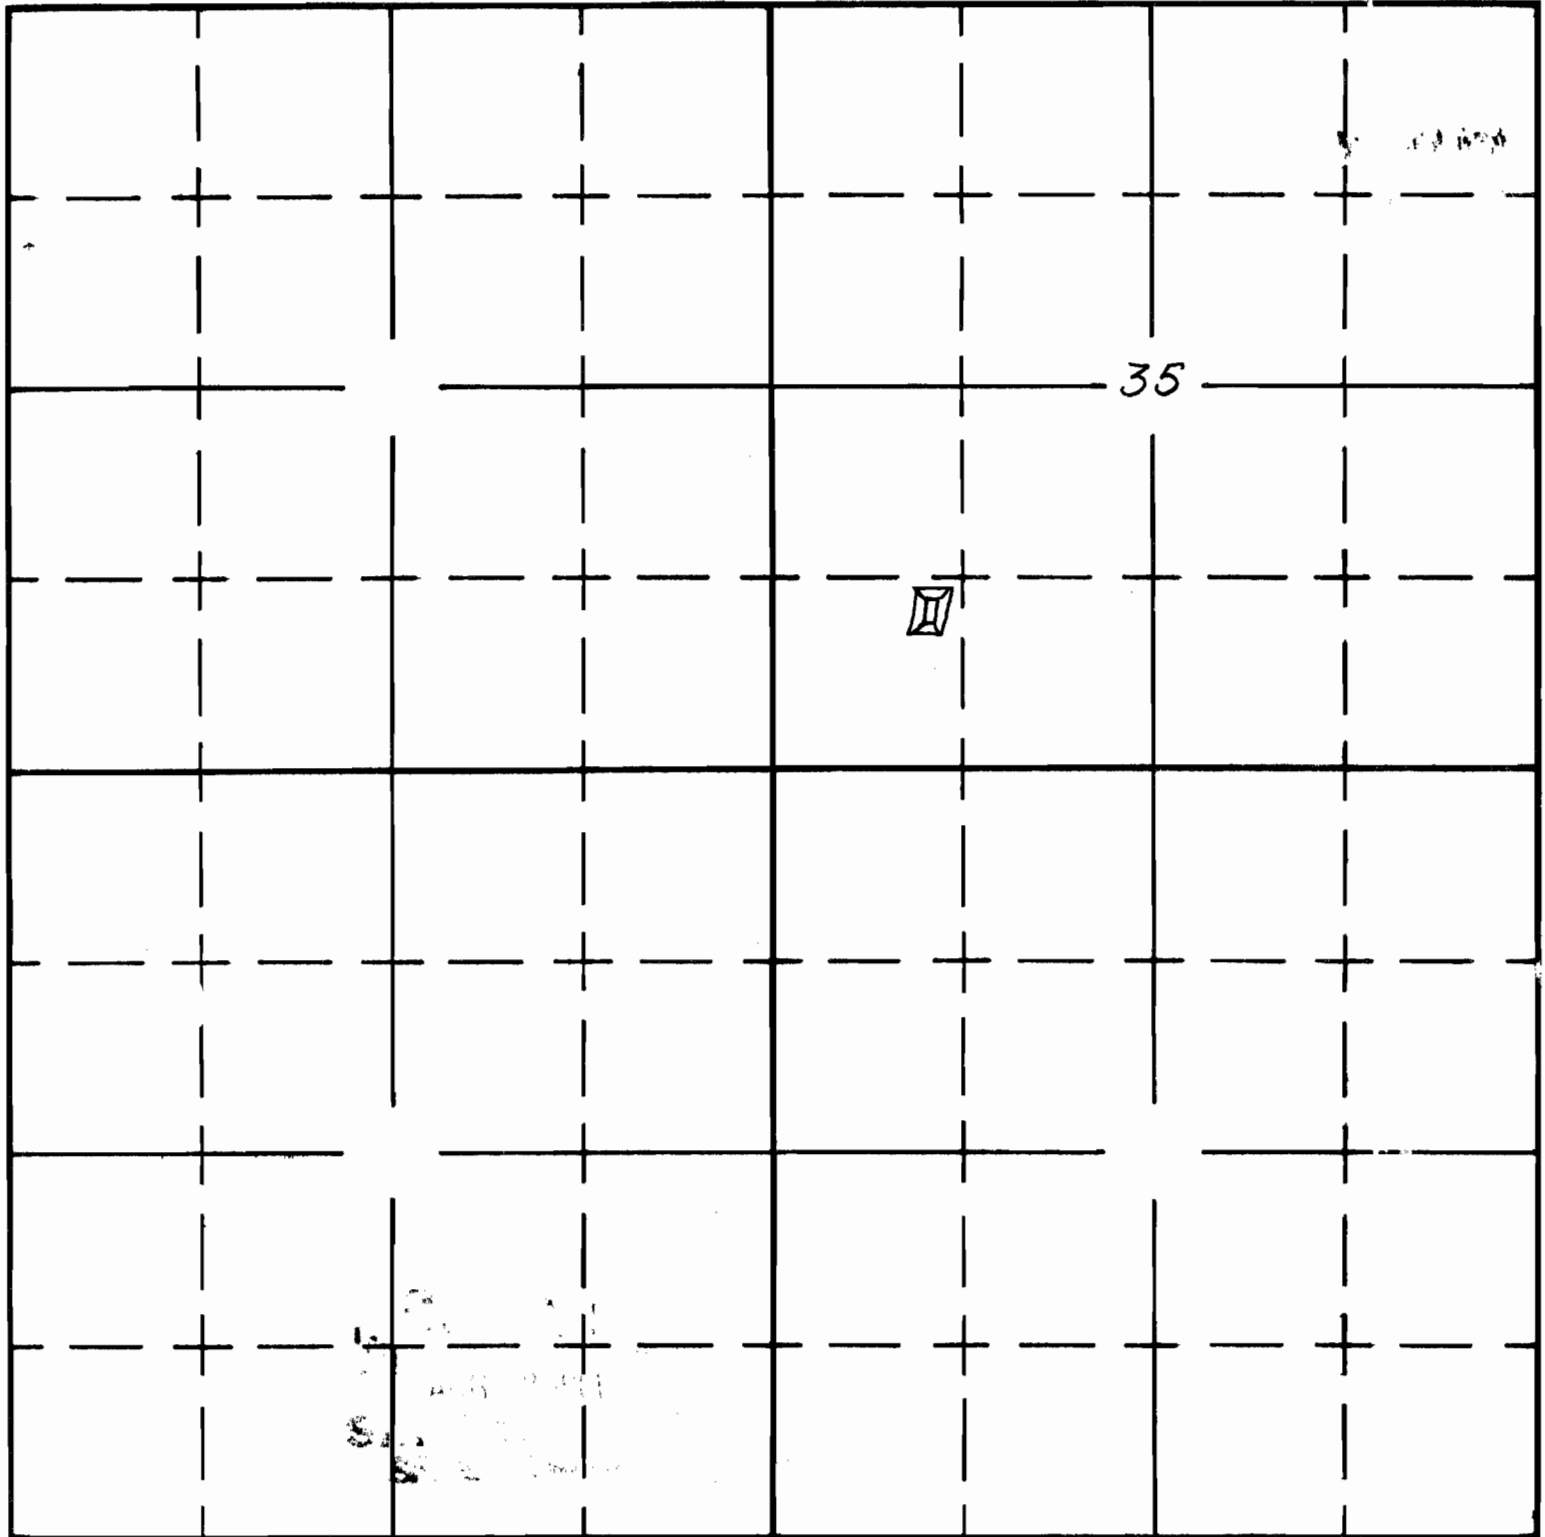

South

APPLICATION No. R-36035
PERMIT R-0013