

Form AI-187
March 1961

UNITED STATES
DEPARTMENT OF THE INTERIOR
BUREAU OF LAND MANAGEMENT

SECTION


SE $\frac{1}{4}$ SW $\frac{1}{4}$

Oregon State Water Filings

SEC 24

TOWNSHIP 24 S., RANGE 24 E., W. M.

North

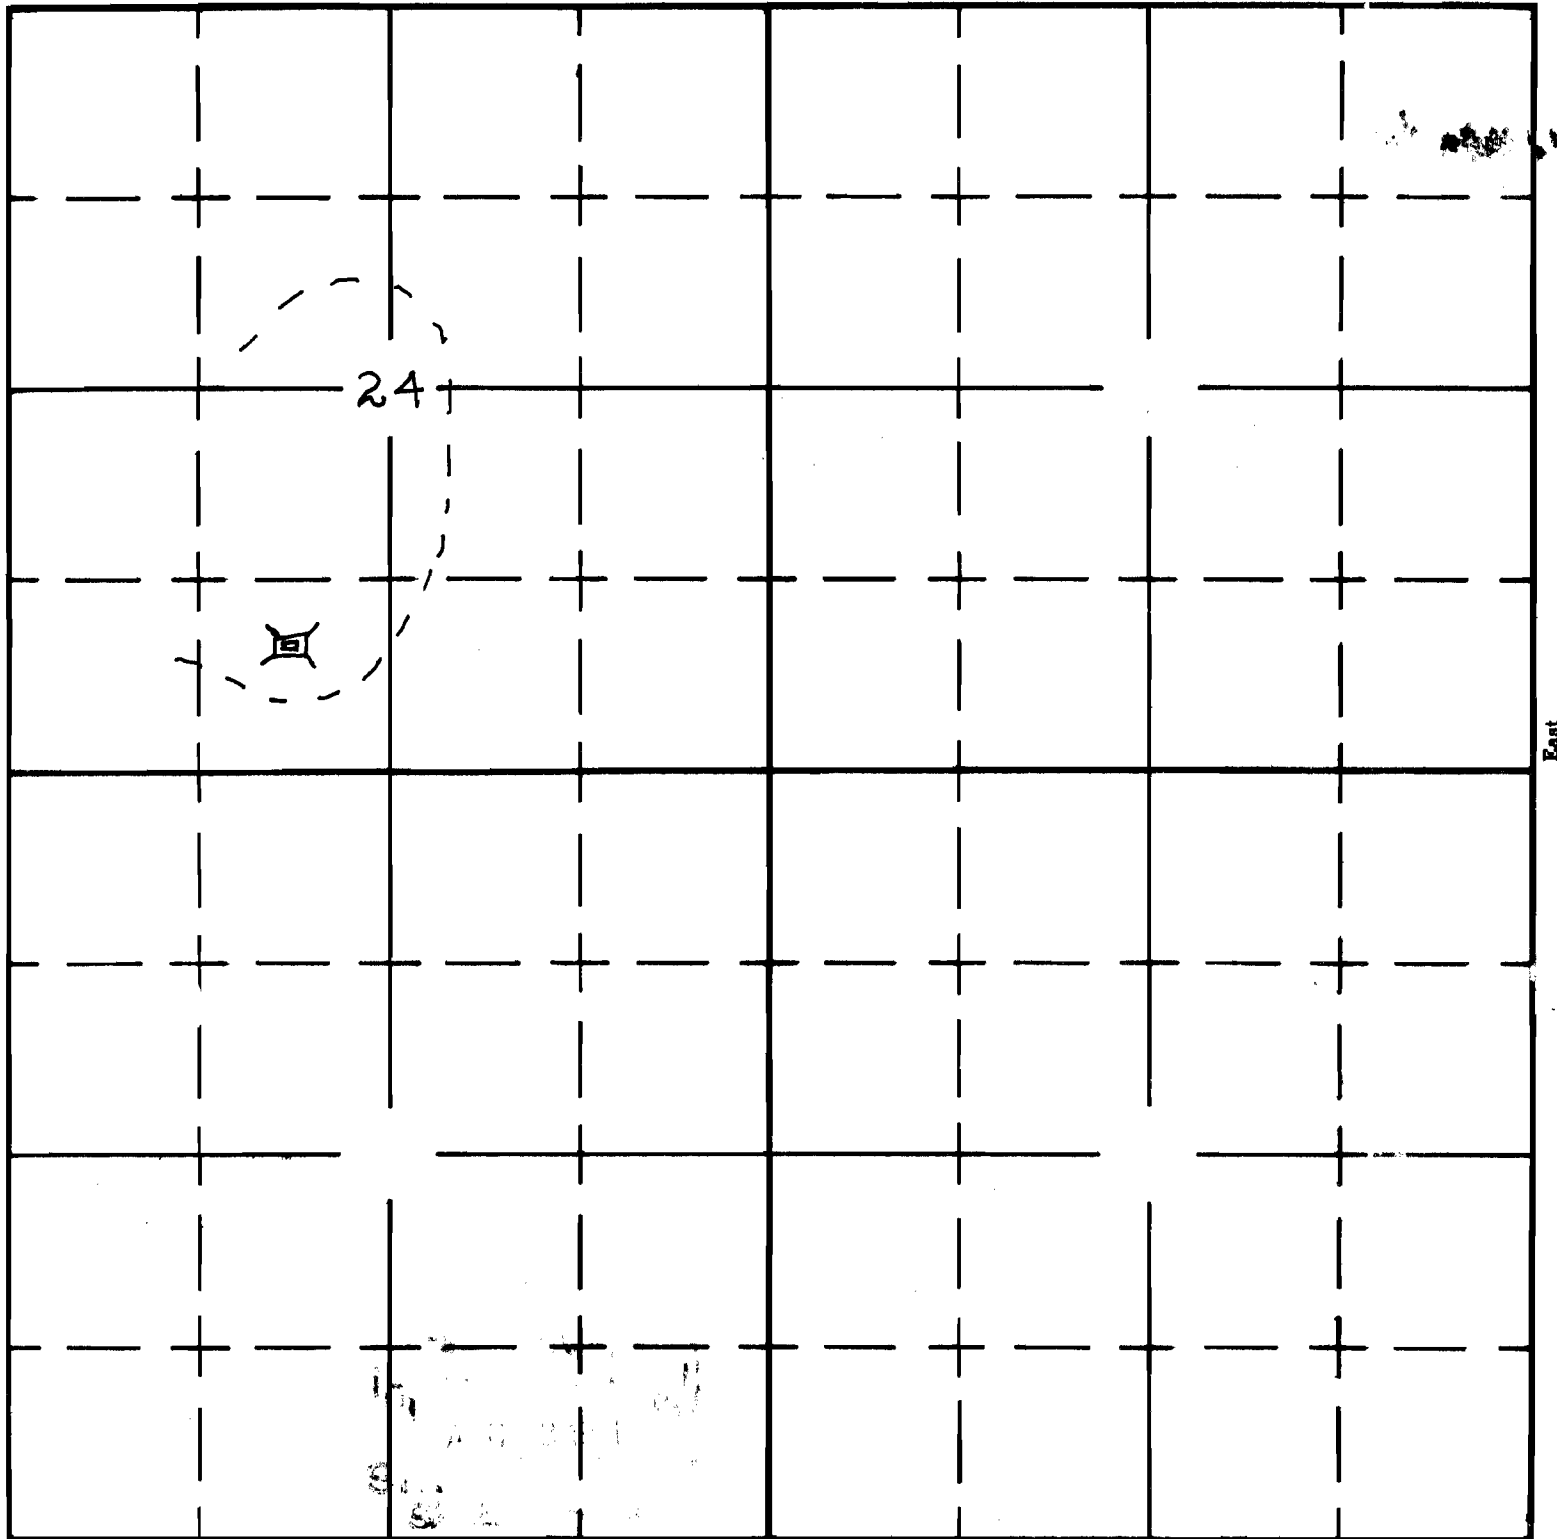

South

APPLICATION No. R-36039
PERMIT No. R-0015