

UNITED STATES
DEPARTMENT OF THE INTERIOR
BUREAU OF LAND MANAGEMENT

SECTION


Oregon State Water Filings

NE 1/4 SE 1/4

TOWNSHIP 30, RANGE 29, W. M.

Sec 12

North

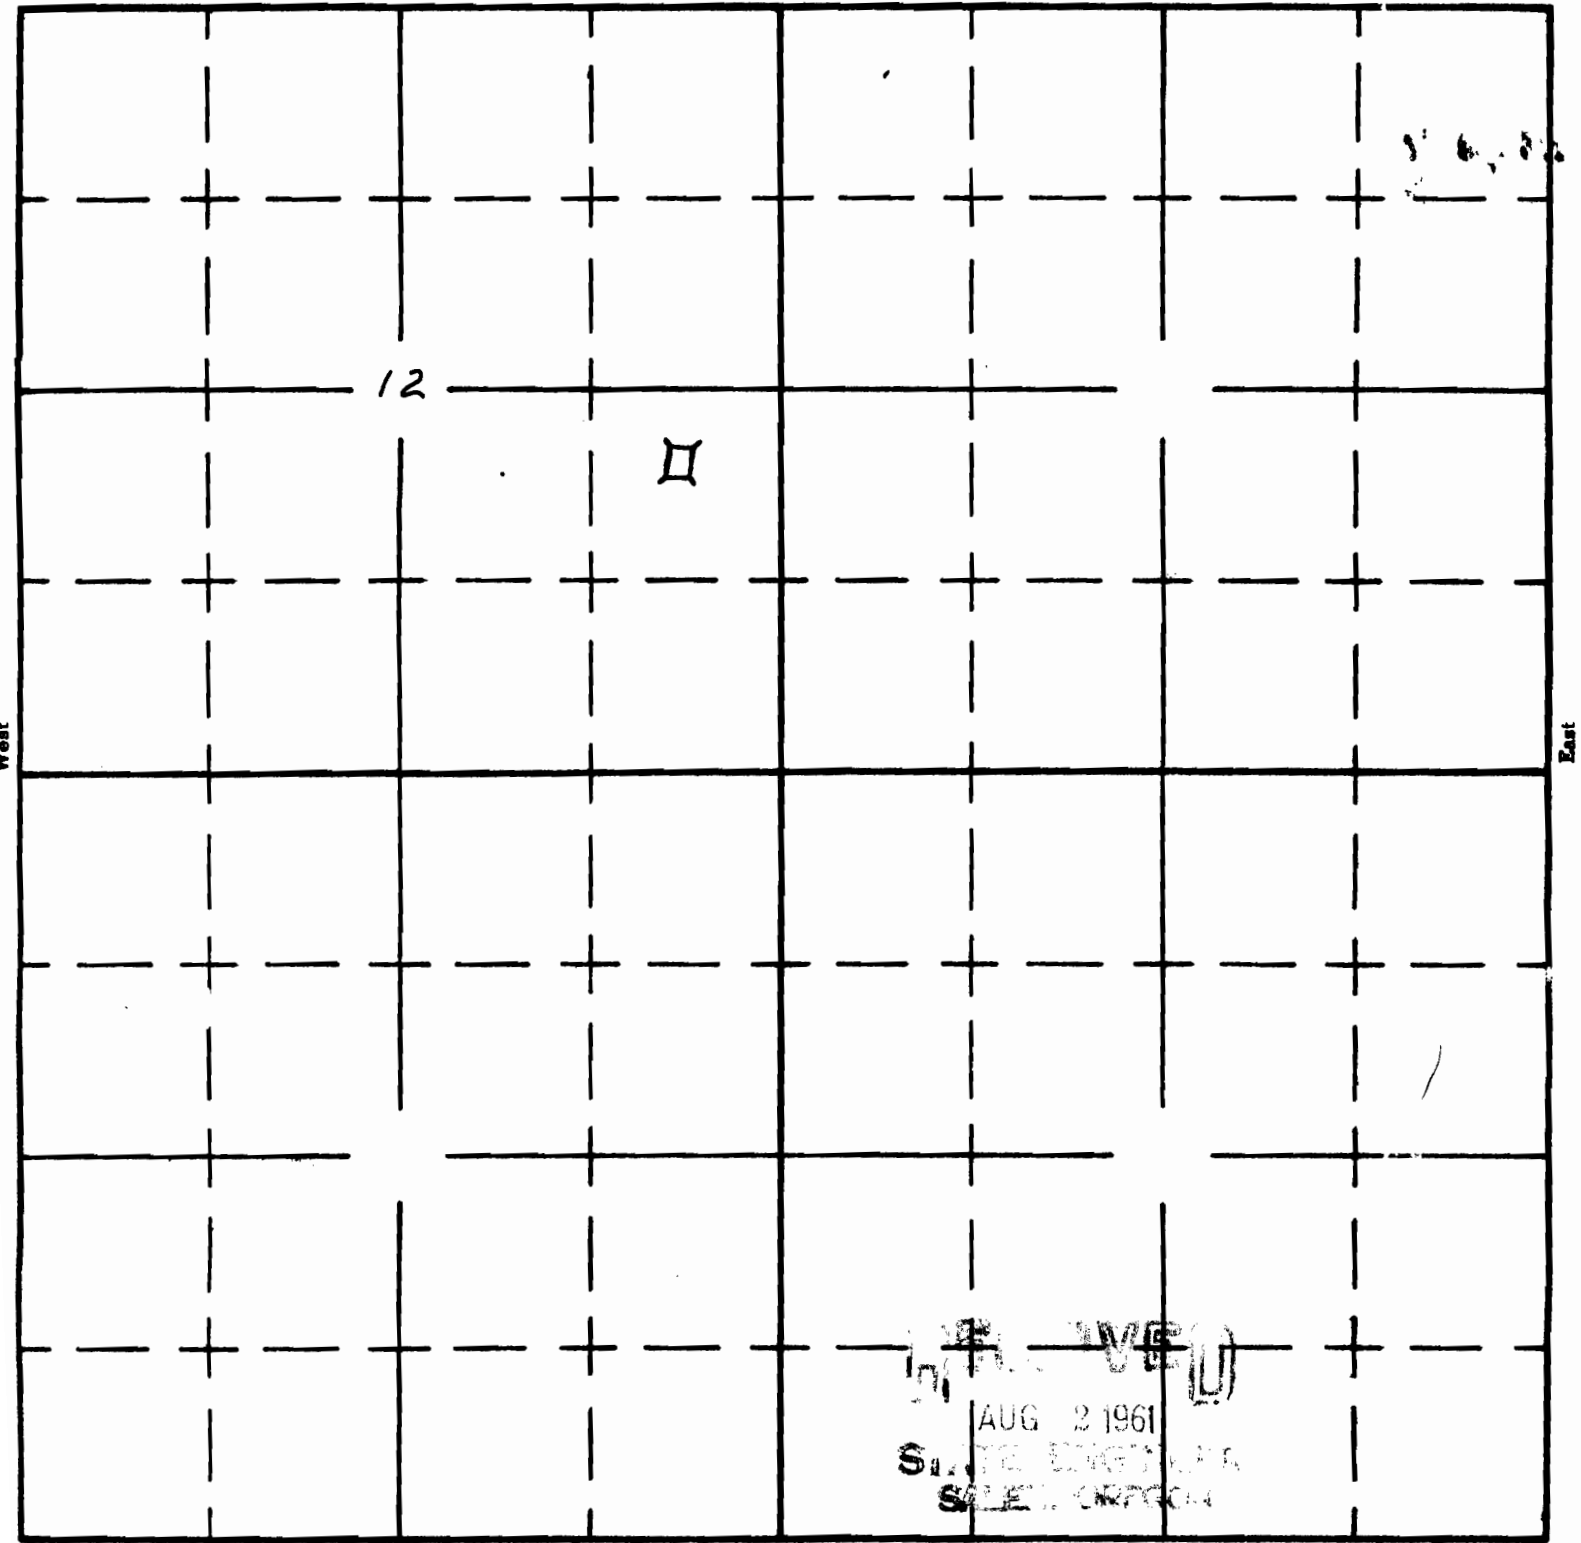

South