


Form AI-187
March 1961

UNITED STATES
DEPARTMENT OF THE INTERIOR
BUREAU OF LAND MANAGEMENT

SECTION
SE¹₄ SE¹₄
SEC 34

Oregon State Water Filings

TOWNSHIP 24S, RANGE 27E, W. M.

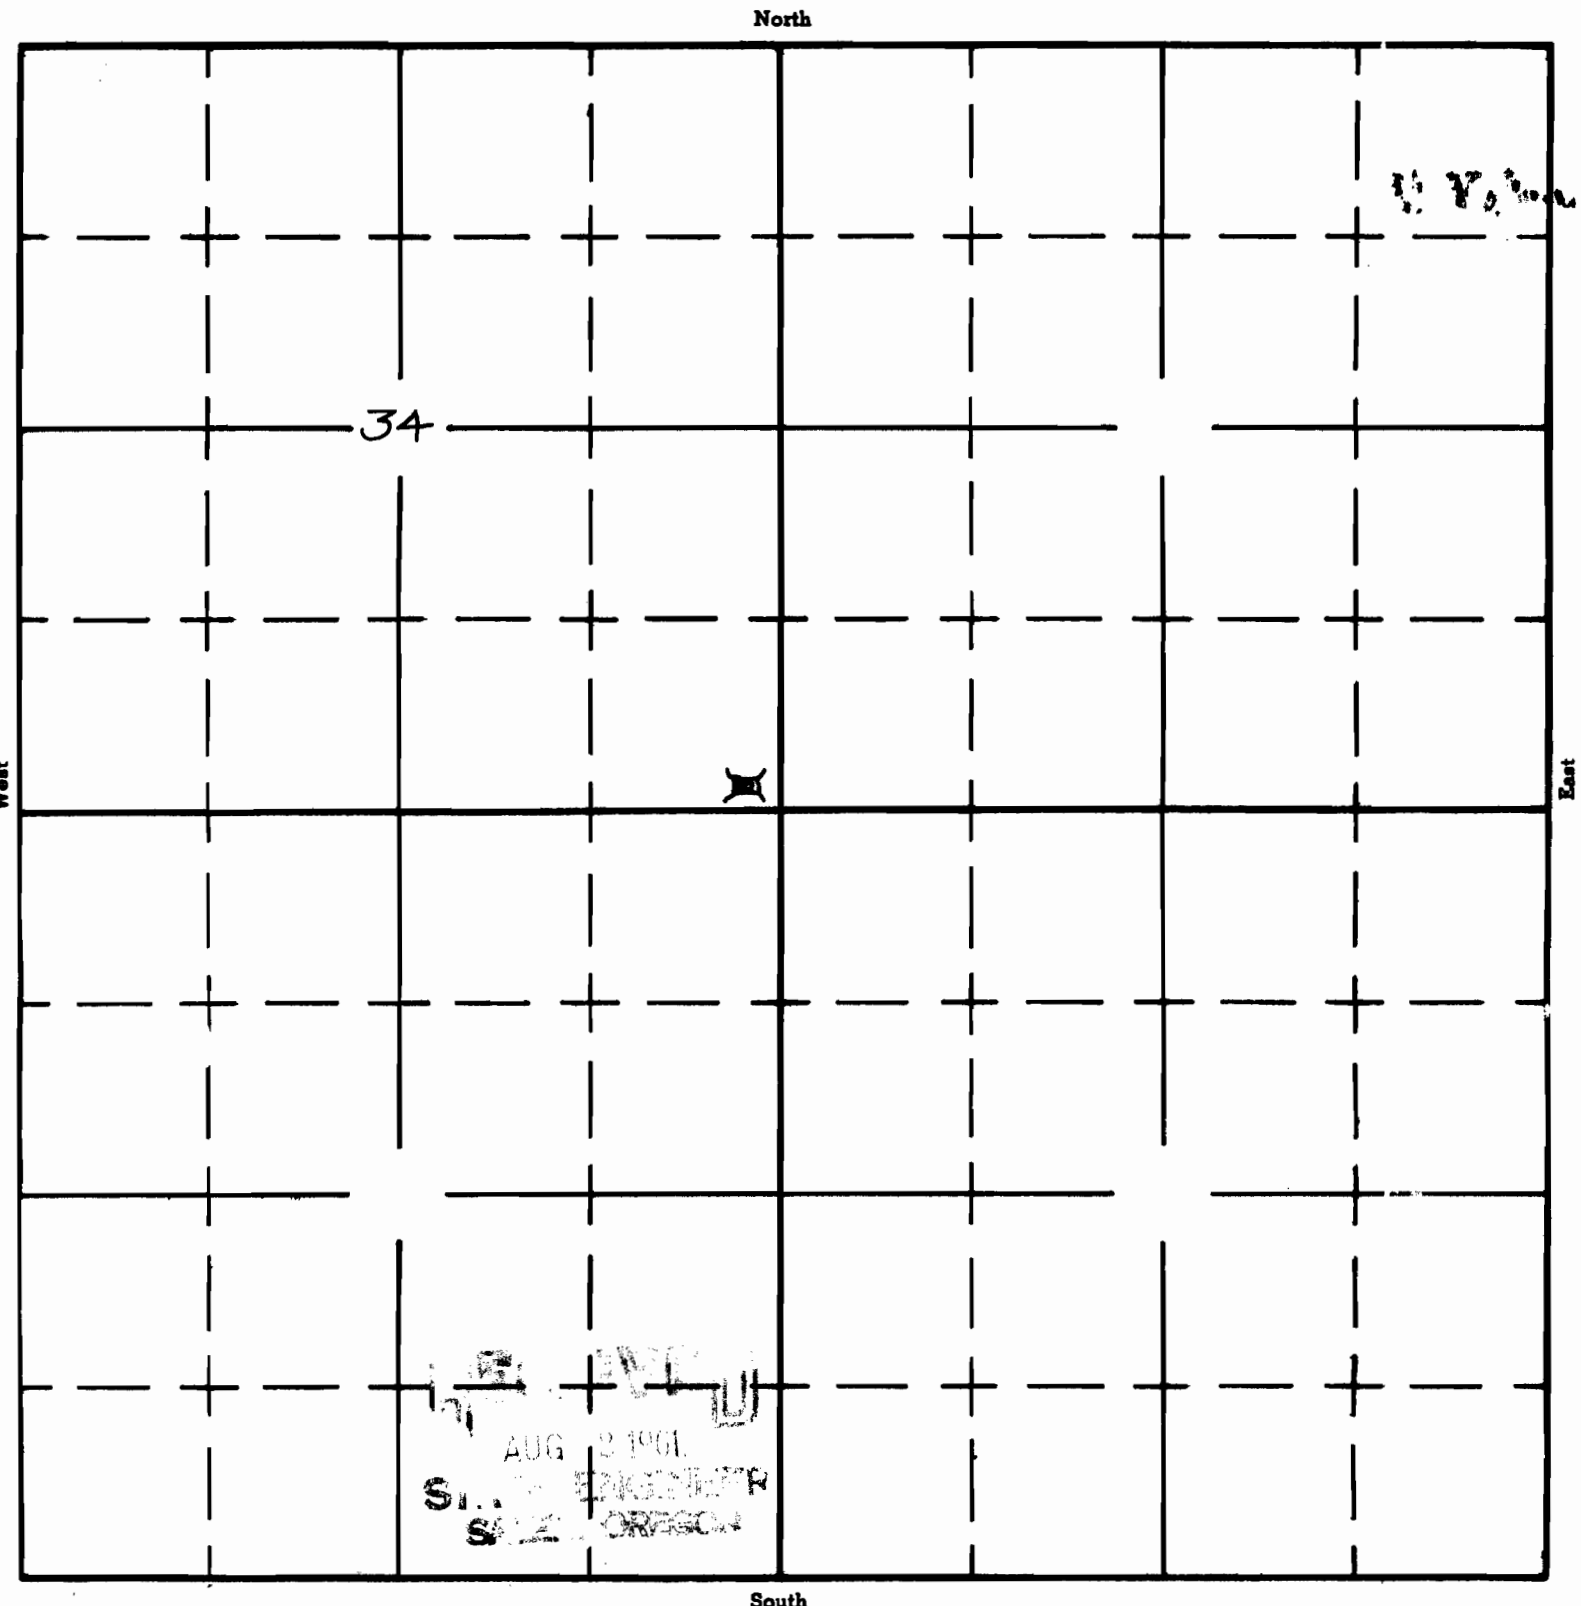

APPLICATION No. R-36057
PERMIT No. R 6122