Form A1-187
March 1961

UNITED STATES
DEPARTMENT OF THE INTERIOR
BUREAU OF LAND MANAGEMENT


SECTION

NE 1/4 SW 1/4

Sec 14

Oregon State Water Filings

TOWNSHIP 29S, RANGE 30E, W. M.

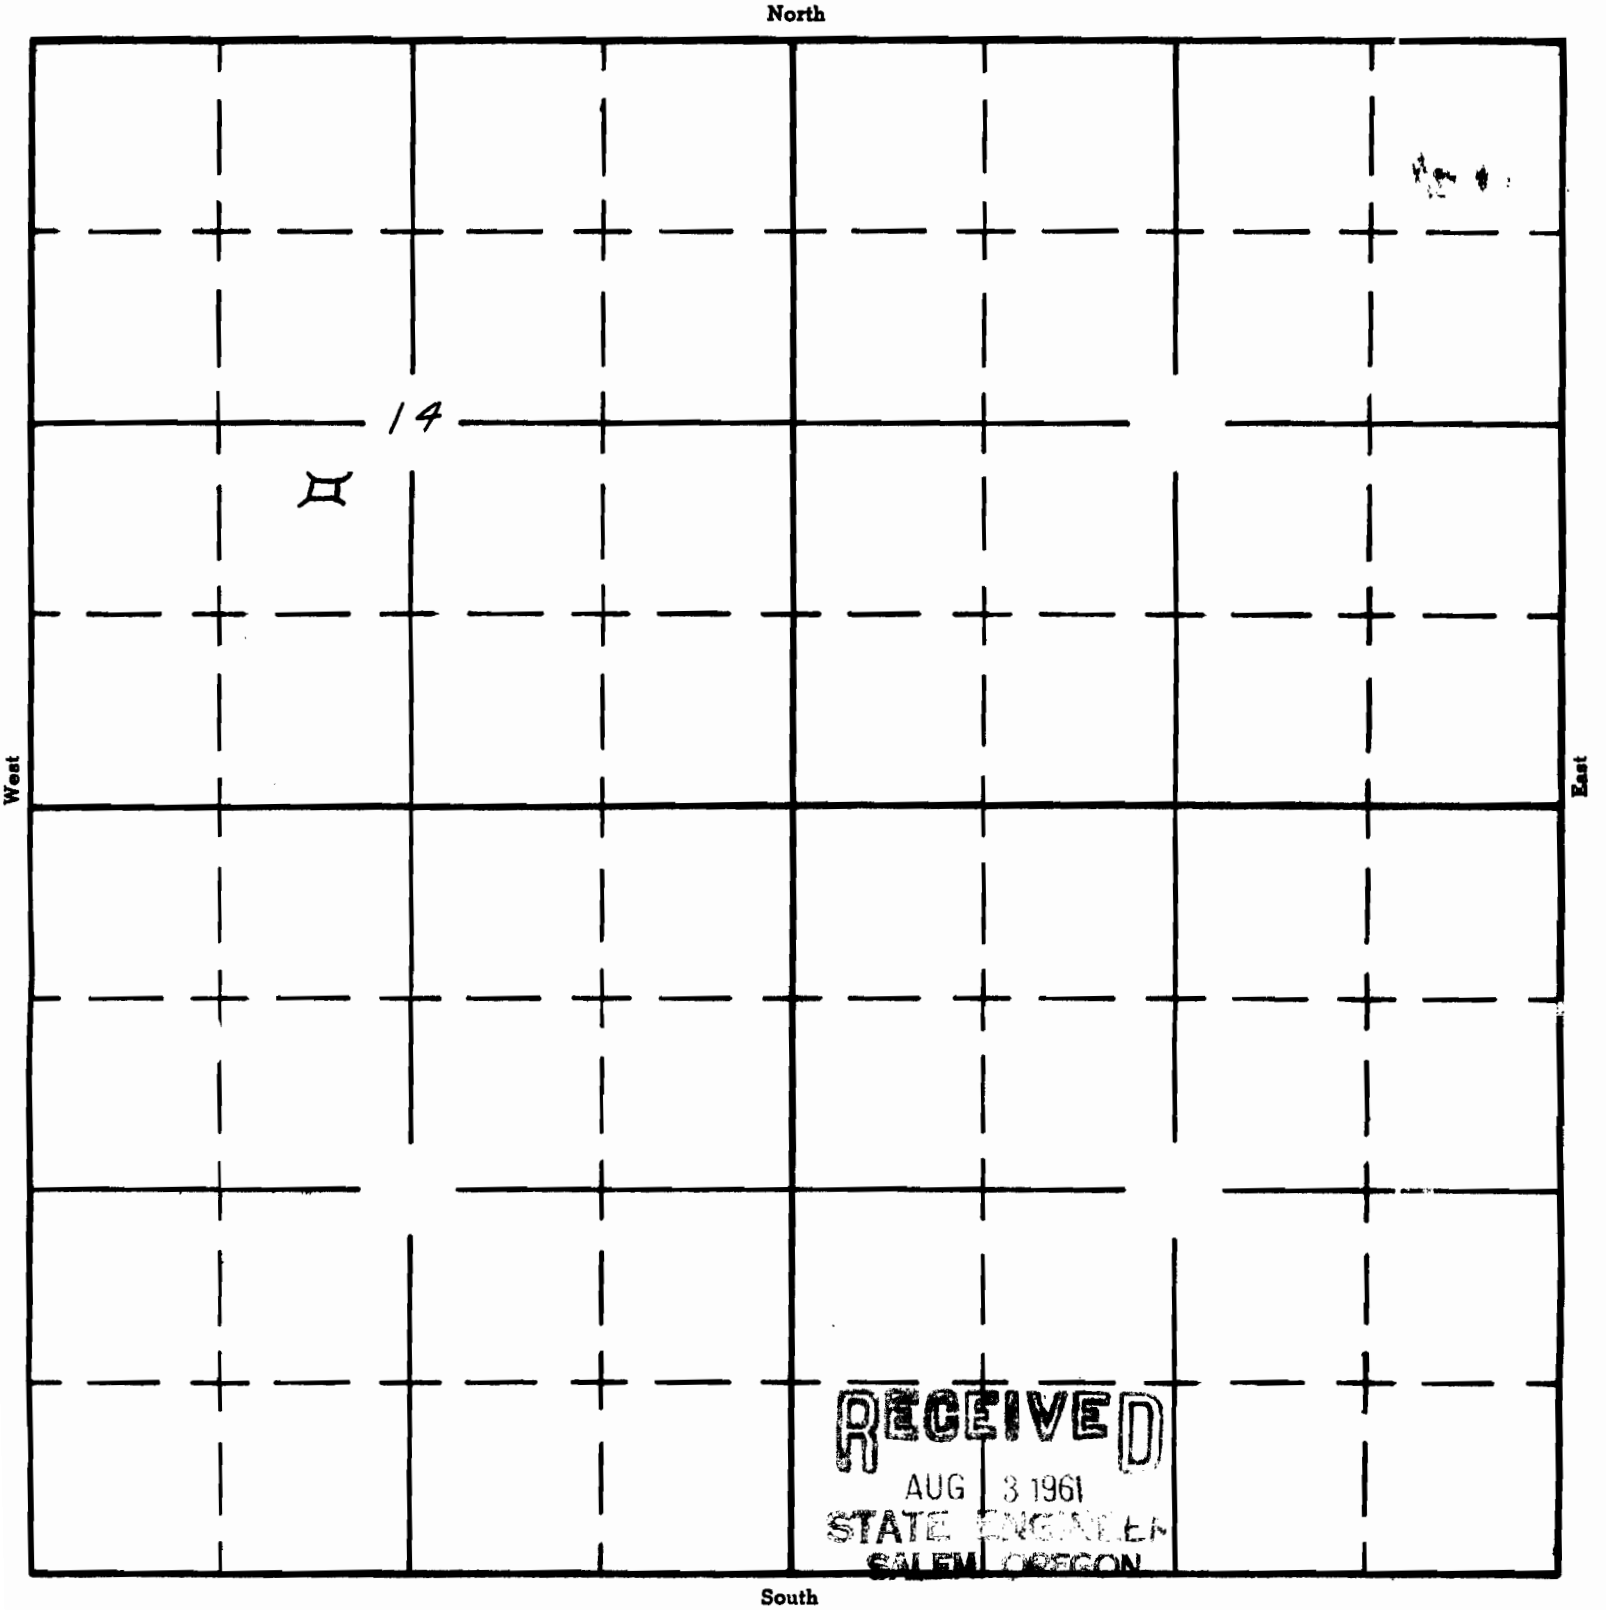

RECEIVED
AUG 3 1961
STATE ENGINEER
SALEM, OREGON

APPLICATION No. R-36067
PERMIT No.