Form A1-187
March 1961


UNITED STATES
DEPARTMENT OF THE INTERIOR
BUREAU OF LAND MANAGEMENT

SECTION

SE ¼ SW ¼
Sec 15

Oregon State Water Filings

TOWNSHIP 23S, RANGE 24E, W. M.

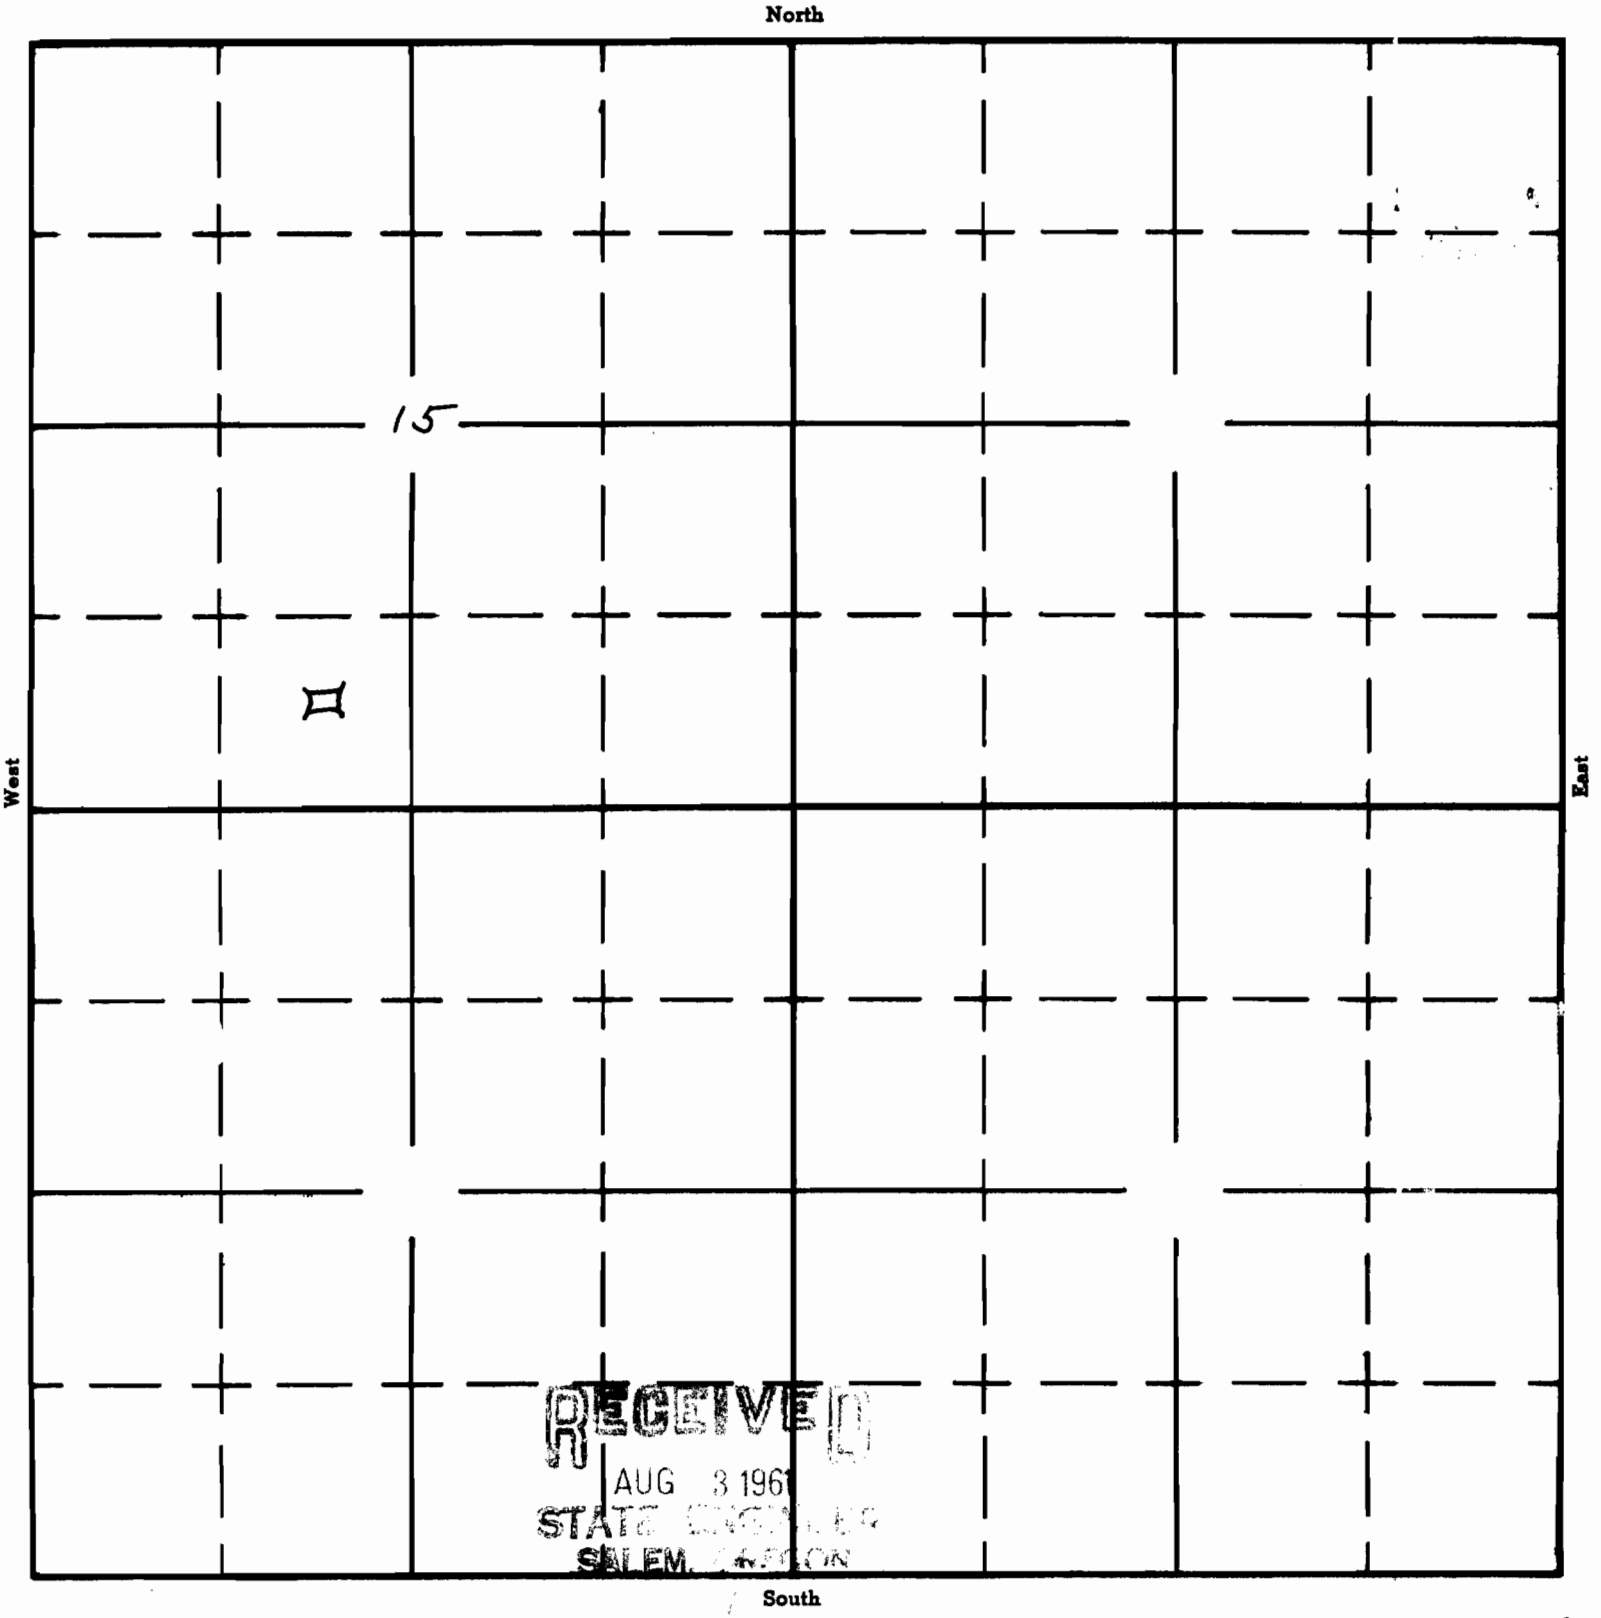

RECEIVED
AUG 3 1961
STATE ENGINEER
SALEM, OREGON

APPLICATION No. R-36069
PERMIT No. [illegible]