

Form AI-187
March 1961

UNITED STATES
DEPARTMENT OF THE INTERIOR
BUREAU OF LAND MANAGEMENT

SECTION


Oregon State Water Filings

SE 1/4 NW 1/4

TOWNSHIP 39S, RANGE 33E, W. M.

Sec 20

North

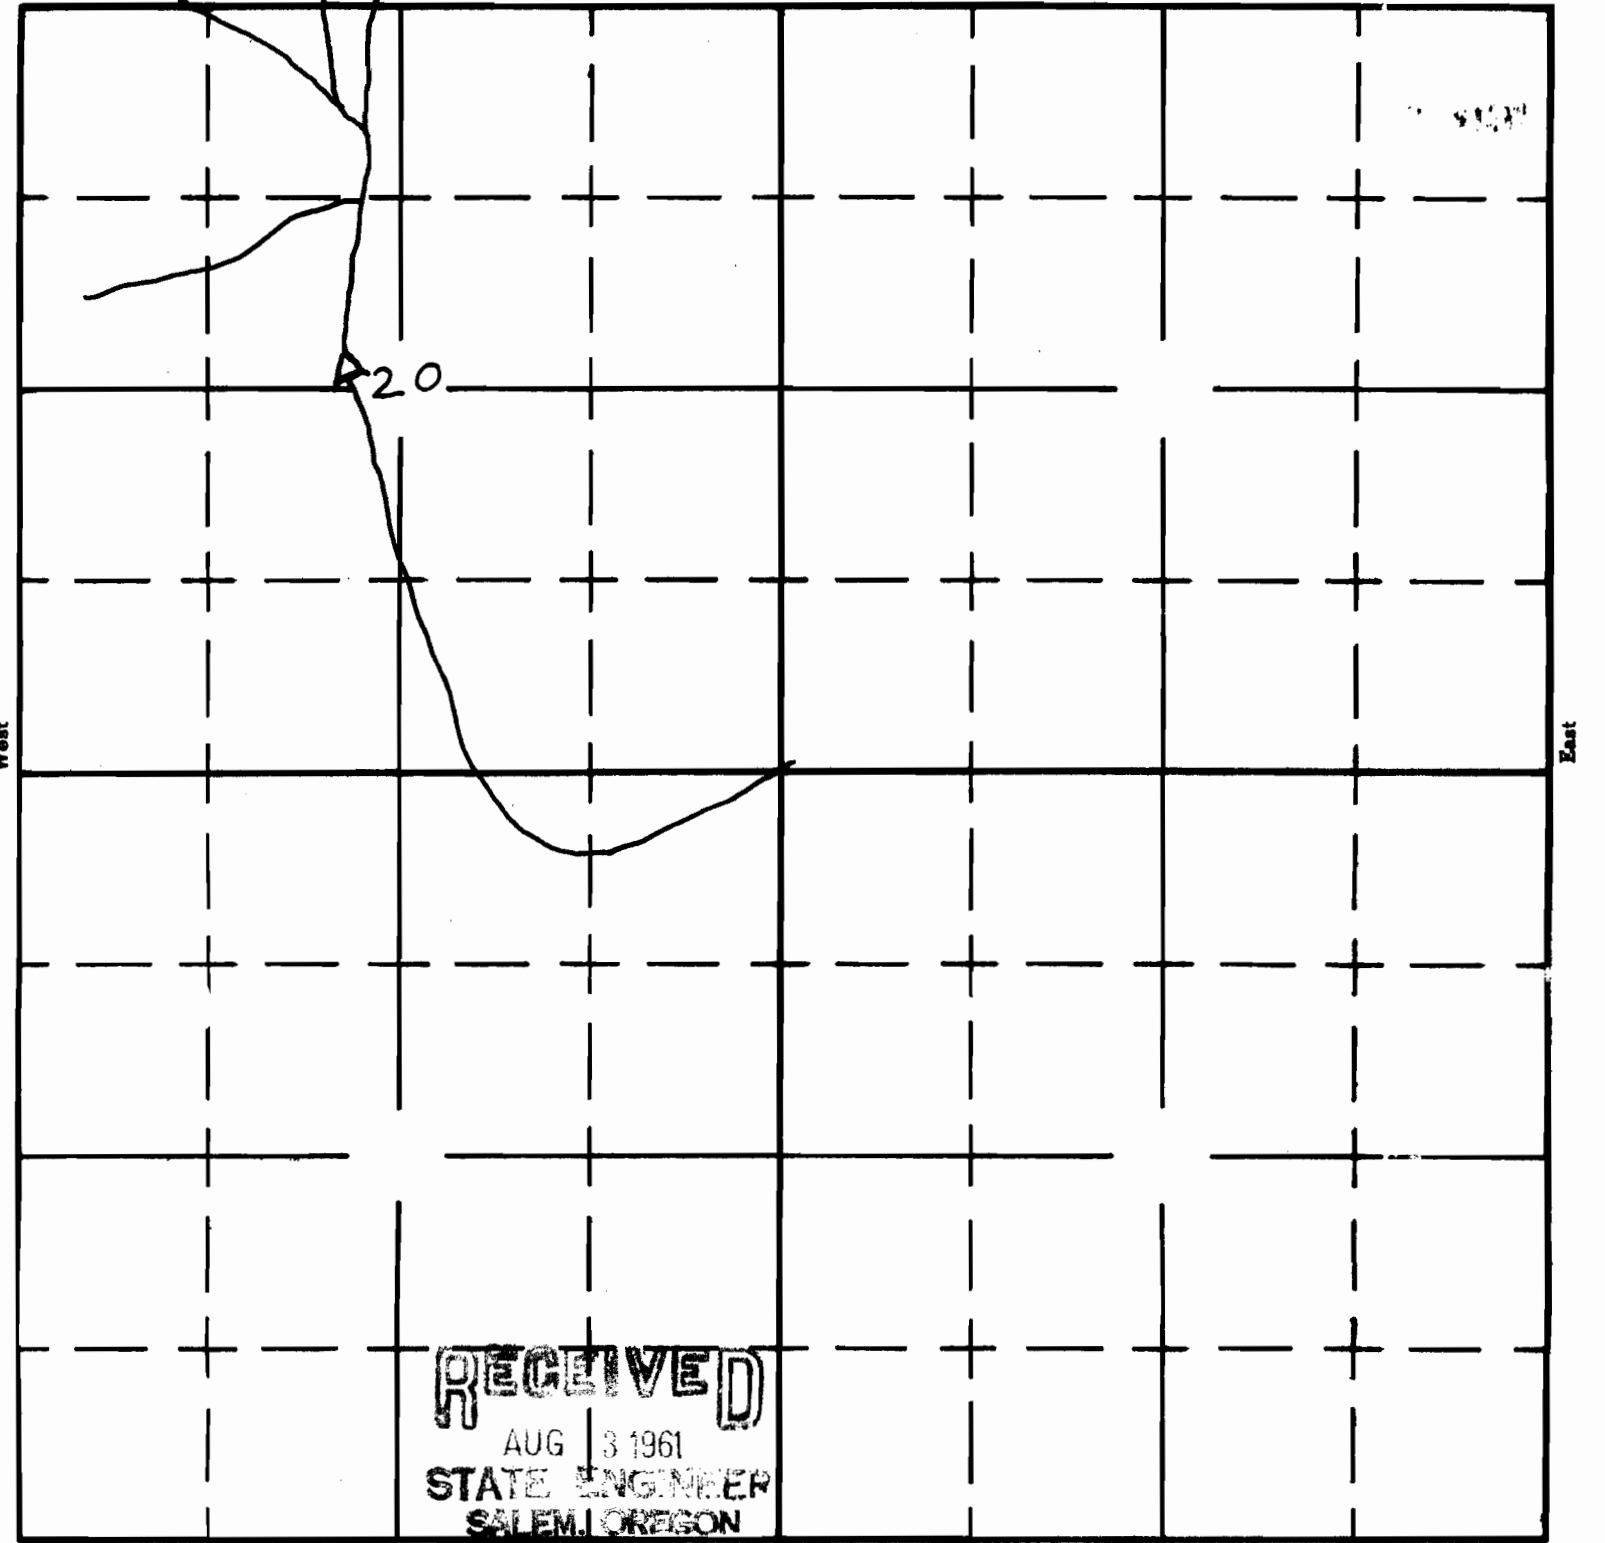

RECEIVED
AUG 3 1961
STATE ENGINEER
SALEM, OREGON

South

APPLICATION No. R-36068

PERMIT No. R 4028