Form A1-187
March 1961

UNITED STATES
DEPARTMENT OF THE INTERIOR
BUREAU OF LAND MANAGEMENT


SECTION

NE 1/4 SE 1/4

Sec 5

Oregon State Water Filings

TOWNSHIP 27S, RANGE 26E, W. M.

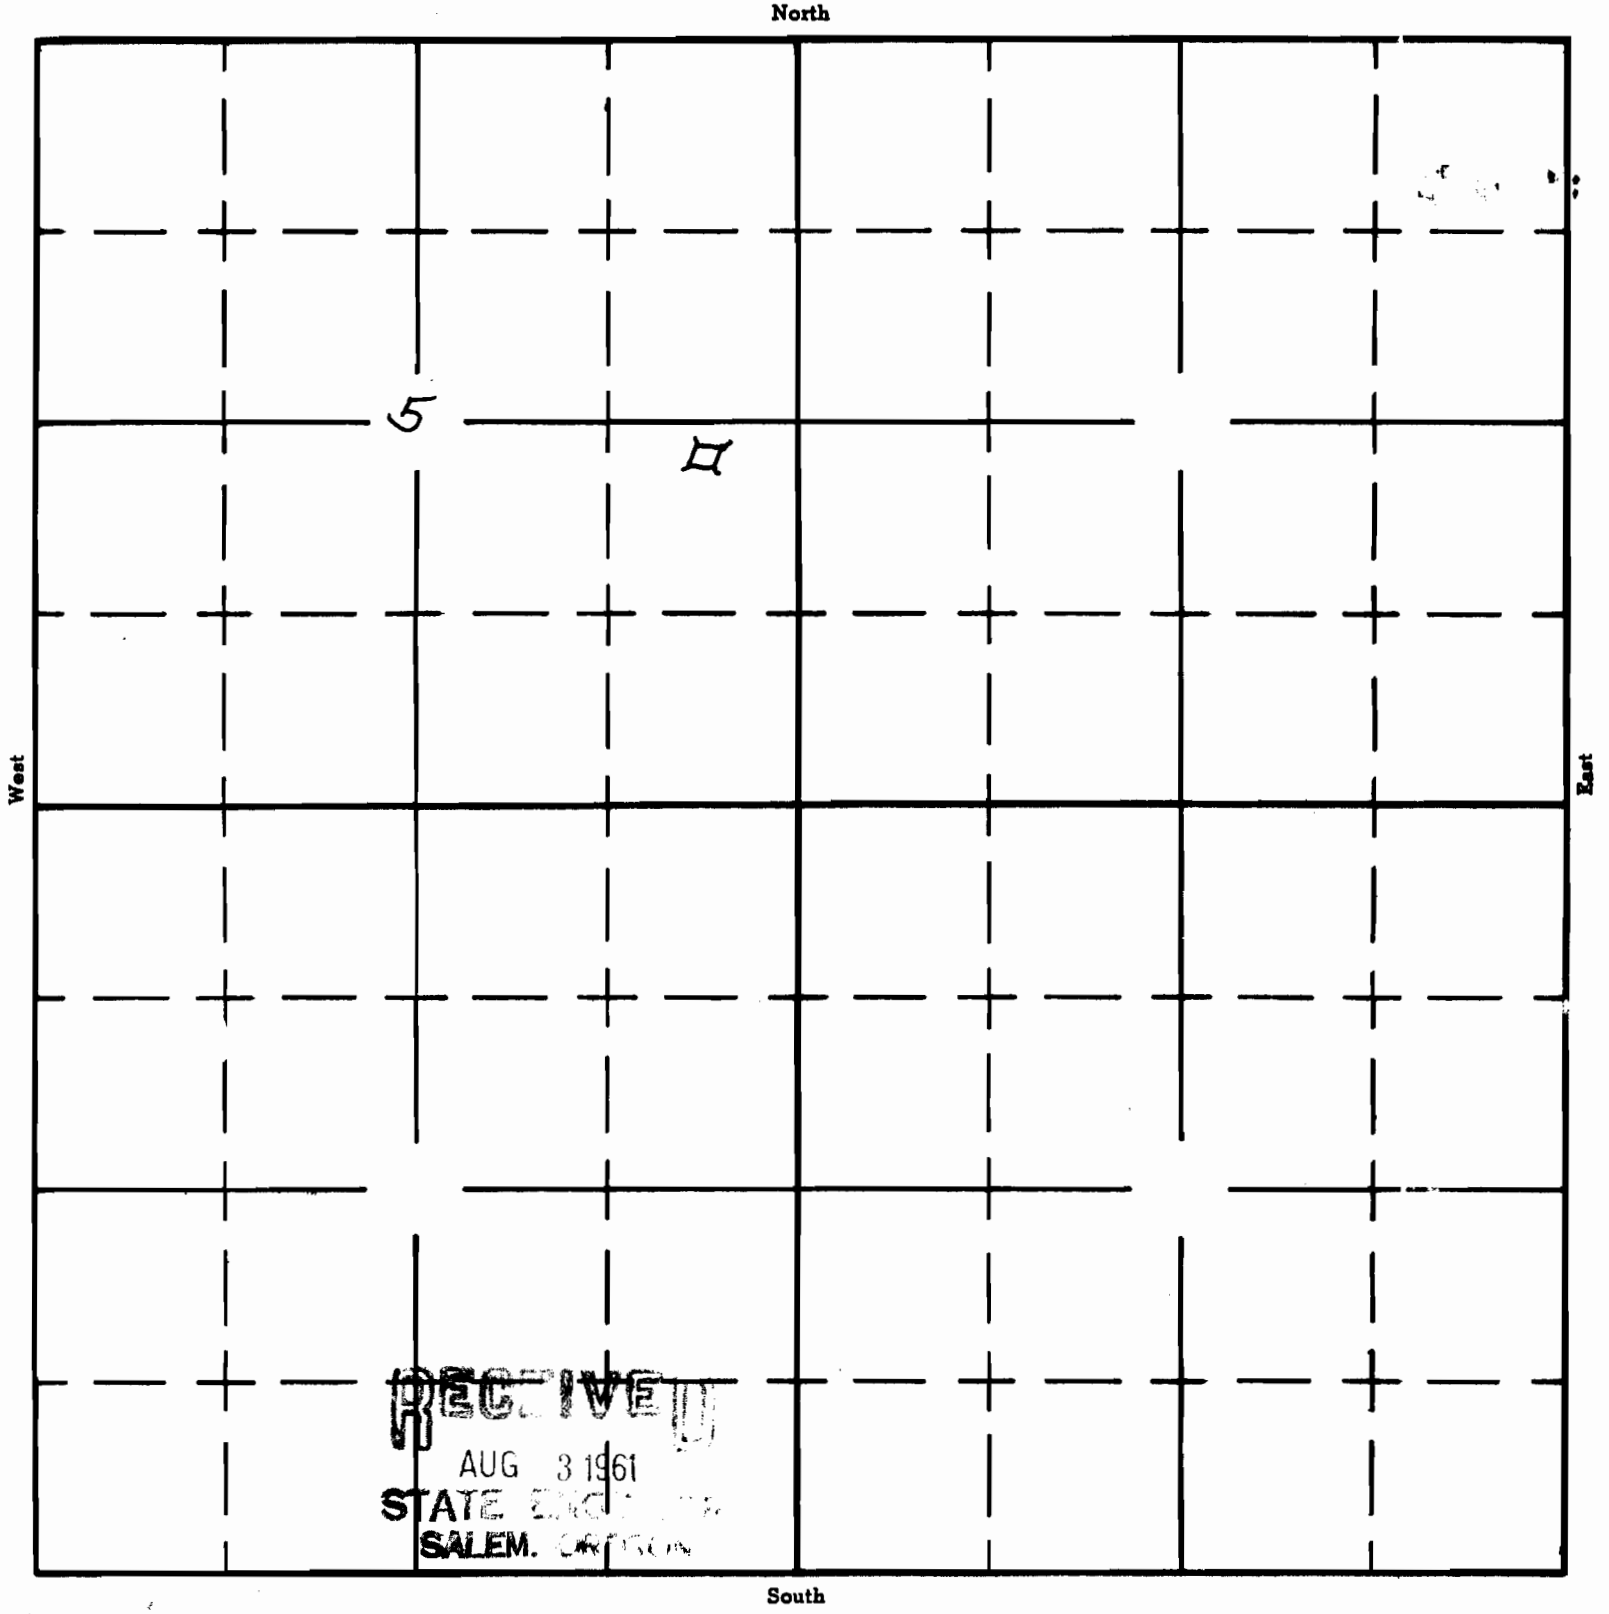

RECEIVED
AUG 3 1961
STATE ENGINEER
SALEM, OREGON

APPLICATION No. R-36085
PERMIT No. 6941