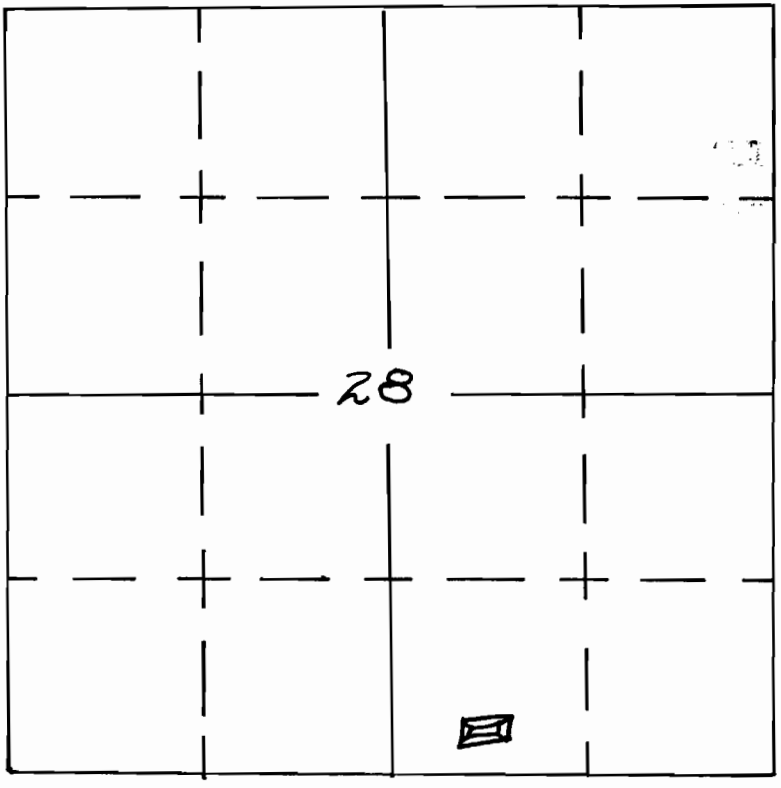

SW¼ SE¼, SECTION 28
T. 26 S., R. 26 E.

Application No. R-36087
Permit No. R 6943