


Form AI-187
March 1961

UNITED STATES
DEPARTMENT OF THE INTERIOR
BUREAU OF LAND MANAGEMENT

SECTION
SE 1/4 NW 1/4
SFC 6

Oregon State Water Filings

TOWNSHIP 27S, RANGE 26E, W. M.

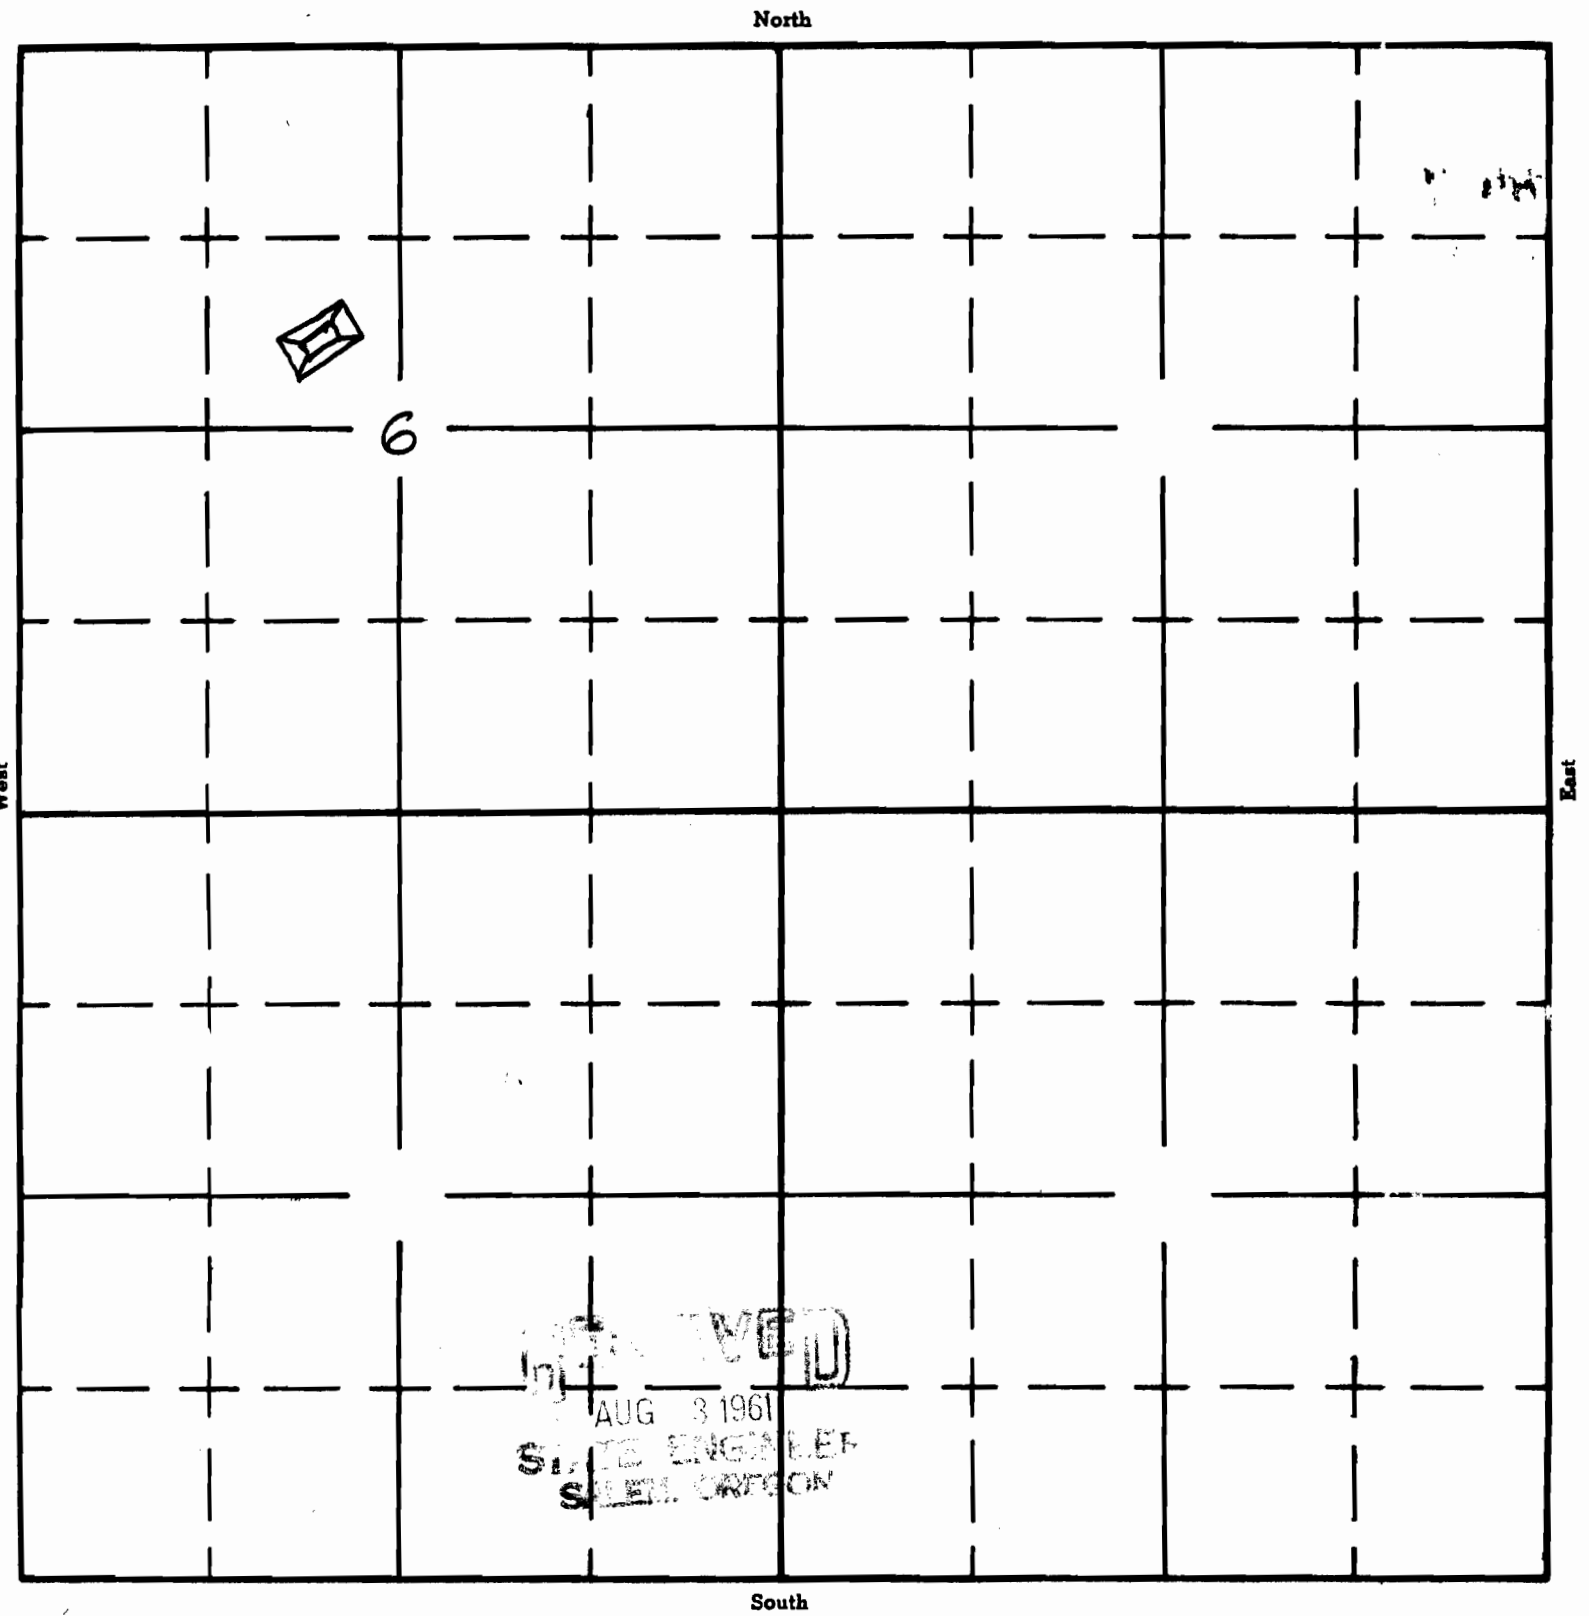

APPLICATION No. R-36088
PERMIT No. 8 6941