


UNITED STATES
DEPARTMENT OF THE INTERIOR
BUREAU OF LAND MANAGEMENT

SECTION
NW 1/4 S 4
SEC 24

Oregon State Water Filings

TOWNSHIP 27S, RANGE 26E, W. M.

North

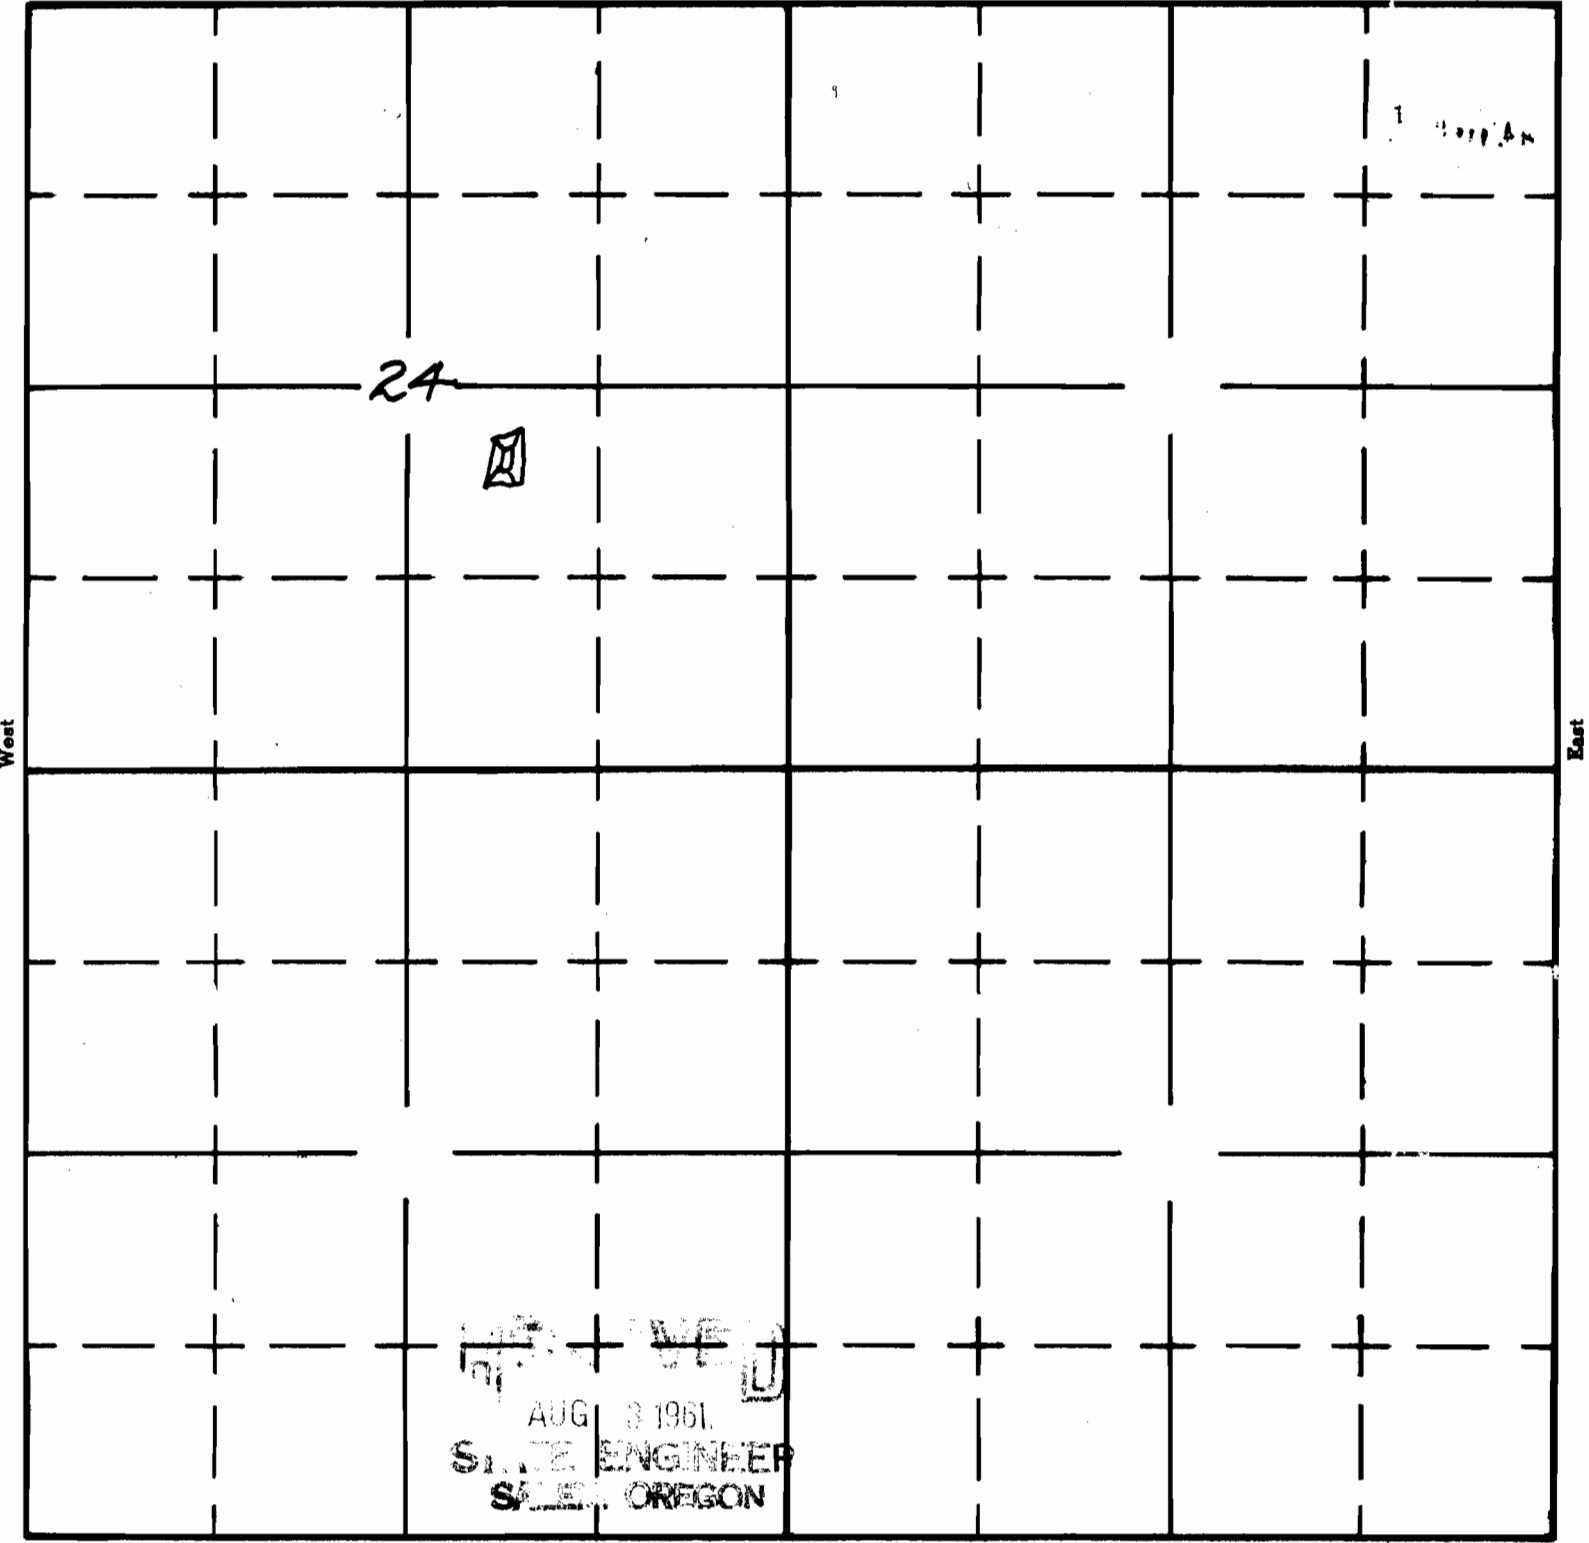

South