

UNITED STATES
DEPARTMENT OF THE INTERIOR
BUREAU OF LAND MANAGEMENT

R6957
63074


SECTION
30

Oregon State Water Filings

SE 1/4 NW 1/4

TOWNSHIP 39S, RANGE 26E, W. M.

Tied in with aerial photos: O.S.H.D. Quad Maps

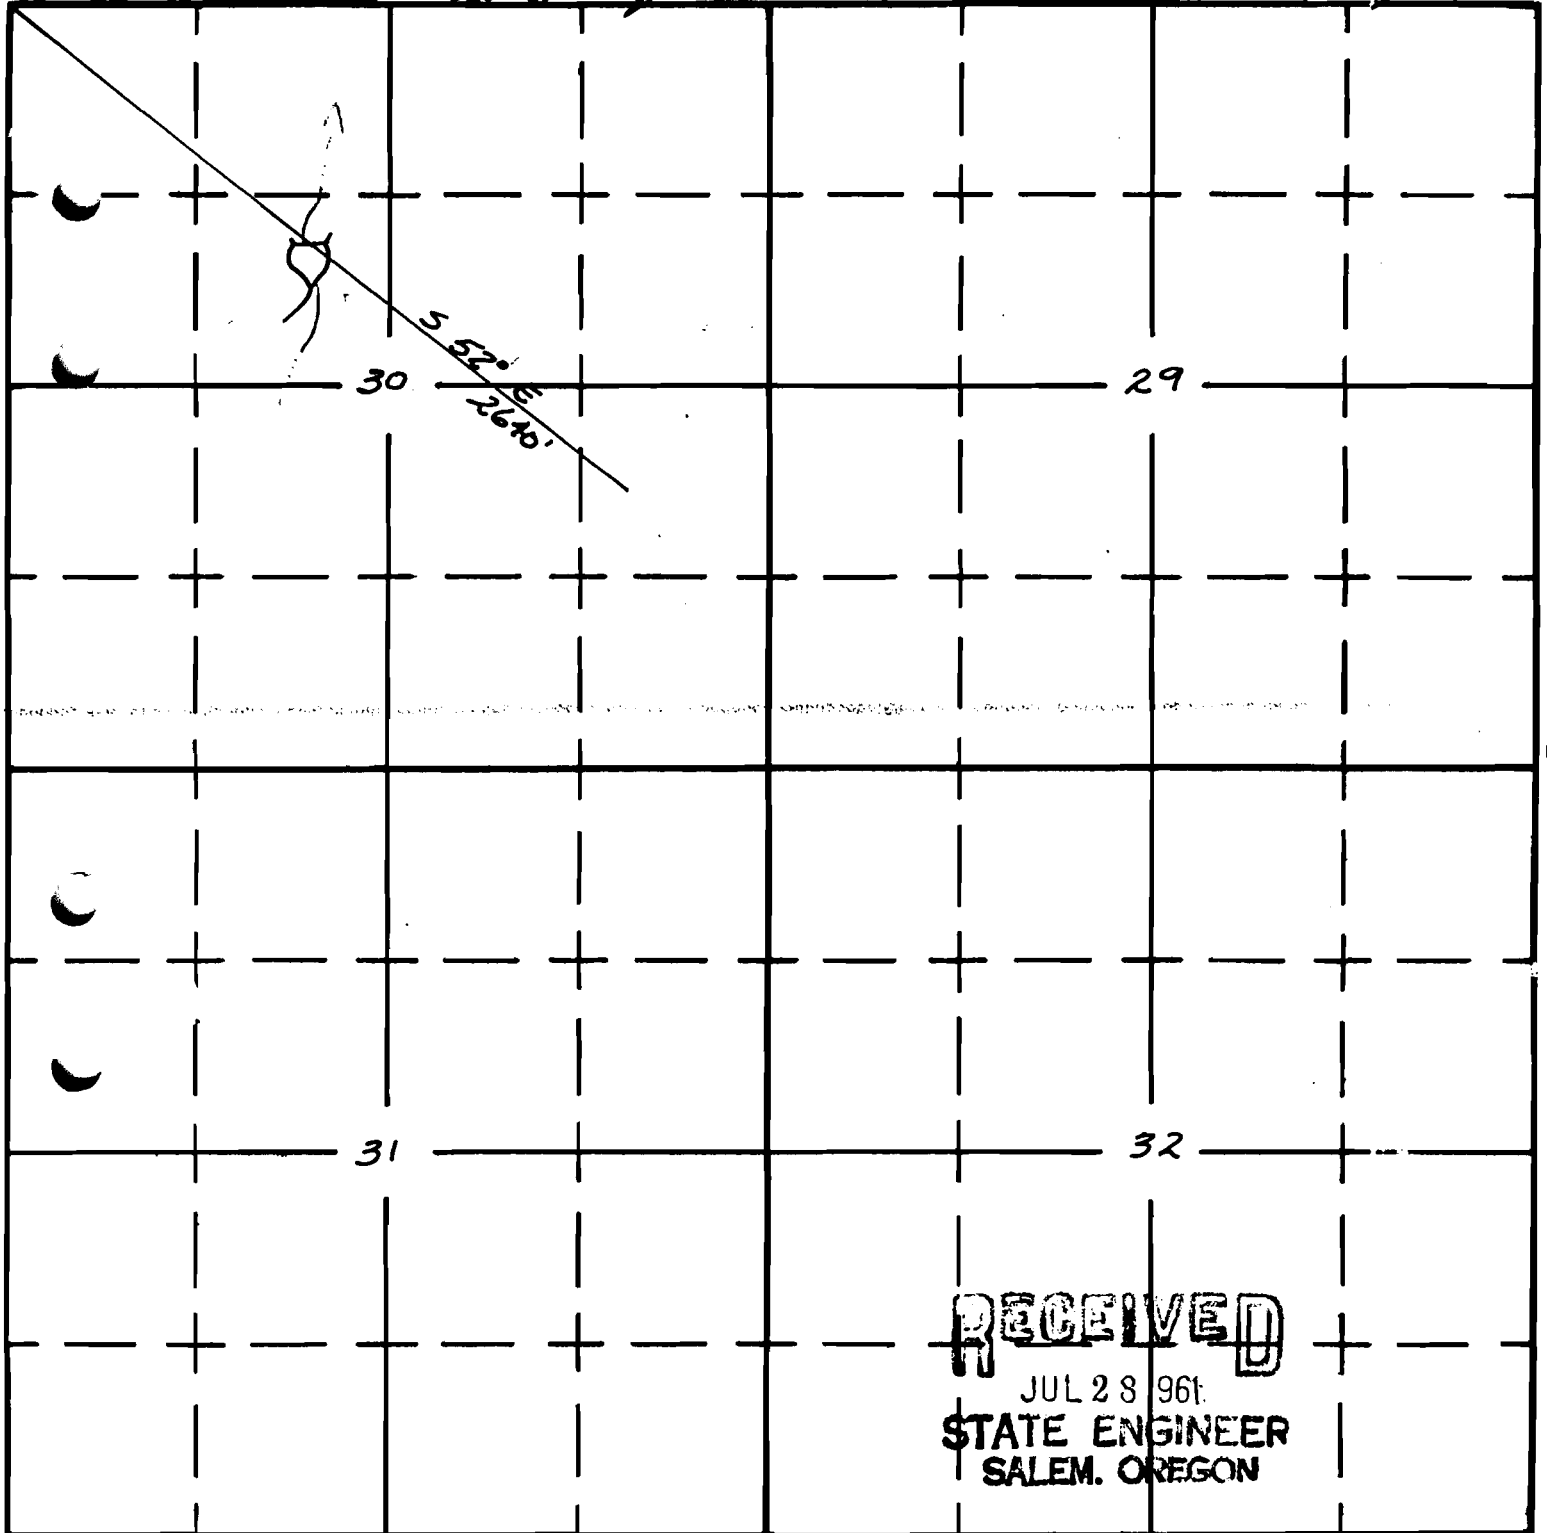

RECEIVED

JUL 28 1961
STATE ENGINEER
SALEM, OREGON

APPLICATION No. R-35801

PERMIT No. **11 6247**