

UNITED STATES
DEPARTMENT OF THE INTERIOR
BUREAU OF LAND MANAGEMENT

R-7007
63076

SECTION


12

Oregon State Water Filings

NW 1/4 NW 1/4

TOWNSHIP 38 S, RANGE 11 E, W. M.

Tied in with aerial photos and O.S.H.D. Quad Maps

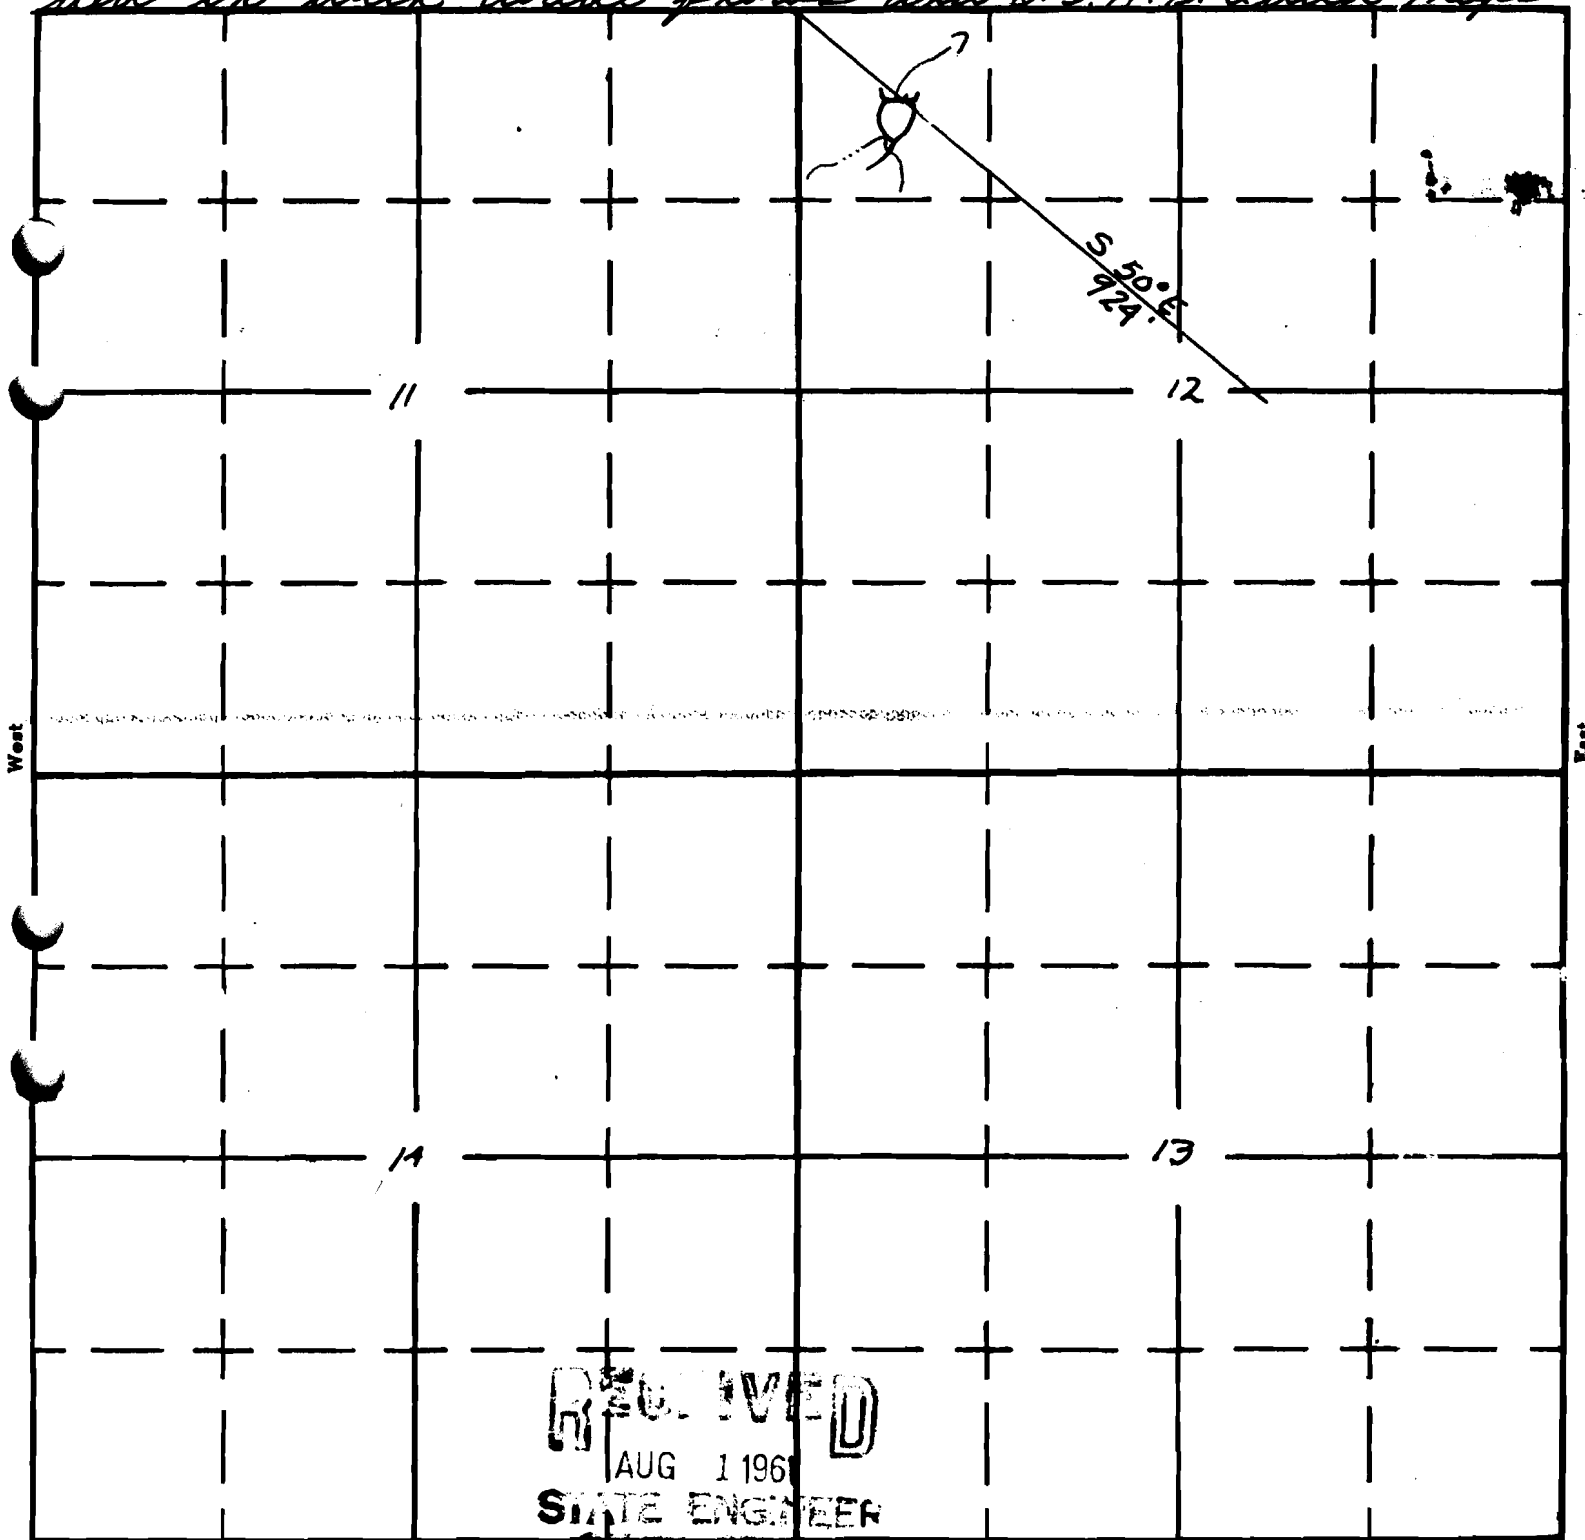

RECEIVED
AUG 1 1961
STATE ENGINEER
Salem, Oregon

APPLICATION No. R-35996
PERMIT No. 7007