

R-7008
63077

Form AI-187
March 1961

UNITED STATES
DEPARTMENT OF THE INTERIOR
BUREAU OF LAND MANAGEMENT

SECTION

4

NE 1/4 SE 1/4


Oregon State Water Filings

TOWNSHIP 32S, RANGE 19E, W. M.

North

Fishhole Ck. & Misc.

Tied in with aerial photo and GSHA Quad maps.

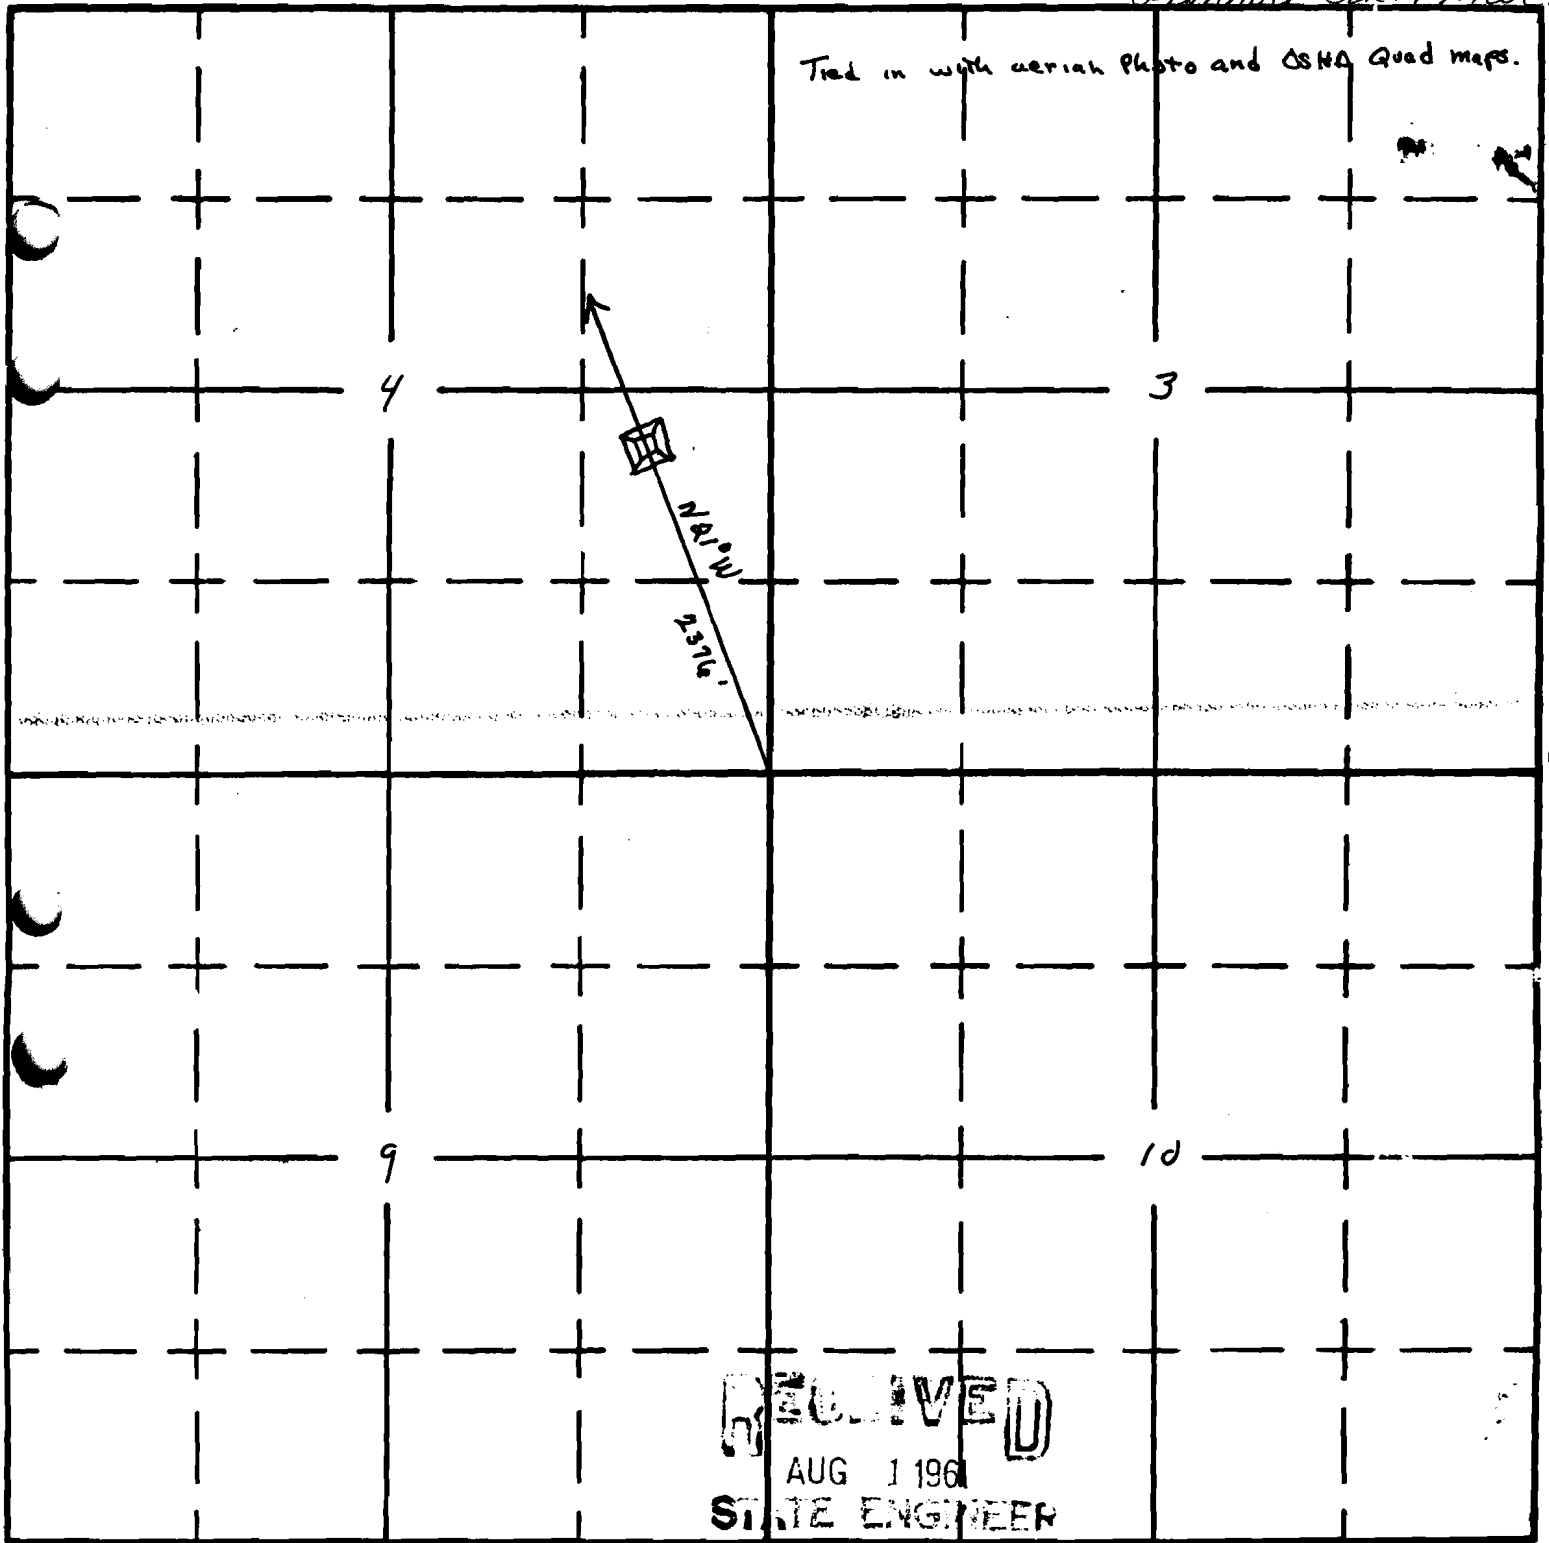

RECEIVED
AUG 1 1961
STATE ENGINEER

