

Form AI-187
March 1961

UNITED STATES
DEPARTMENT OF THE INTERIOR
BUREAU OF LAND MANAGEMENT


SECTION 8

Oregon State Water Filings

NW 1/4 SW 1/4

TOWNSHIP 39S, RANGE 30E, W. M.

TIED - IN WITH AERIAL PHOTOS AND O.S.H.D. ROAD MAPS

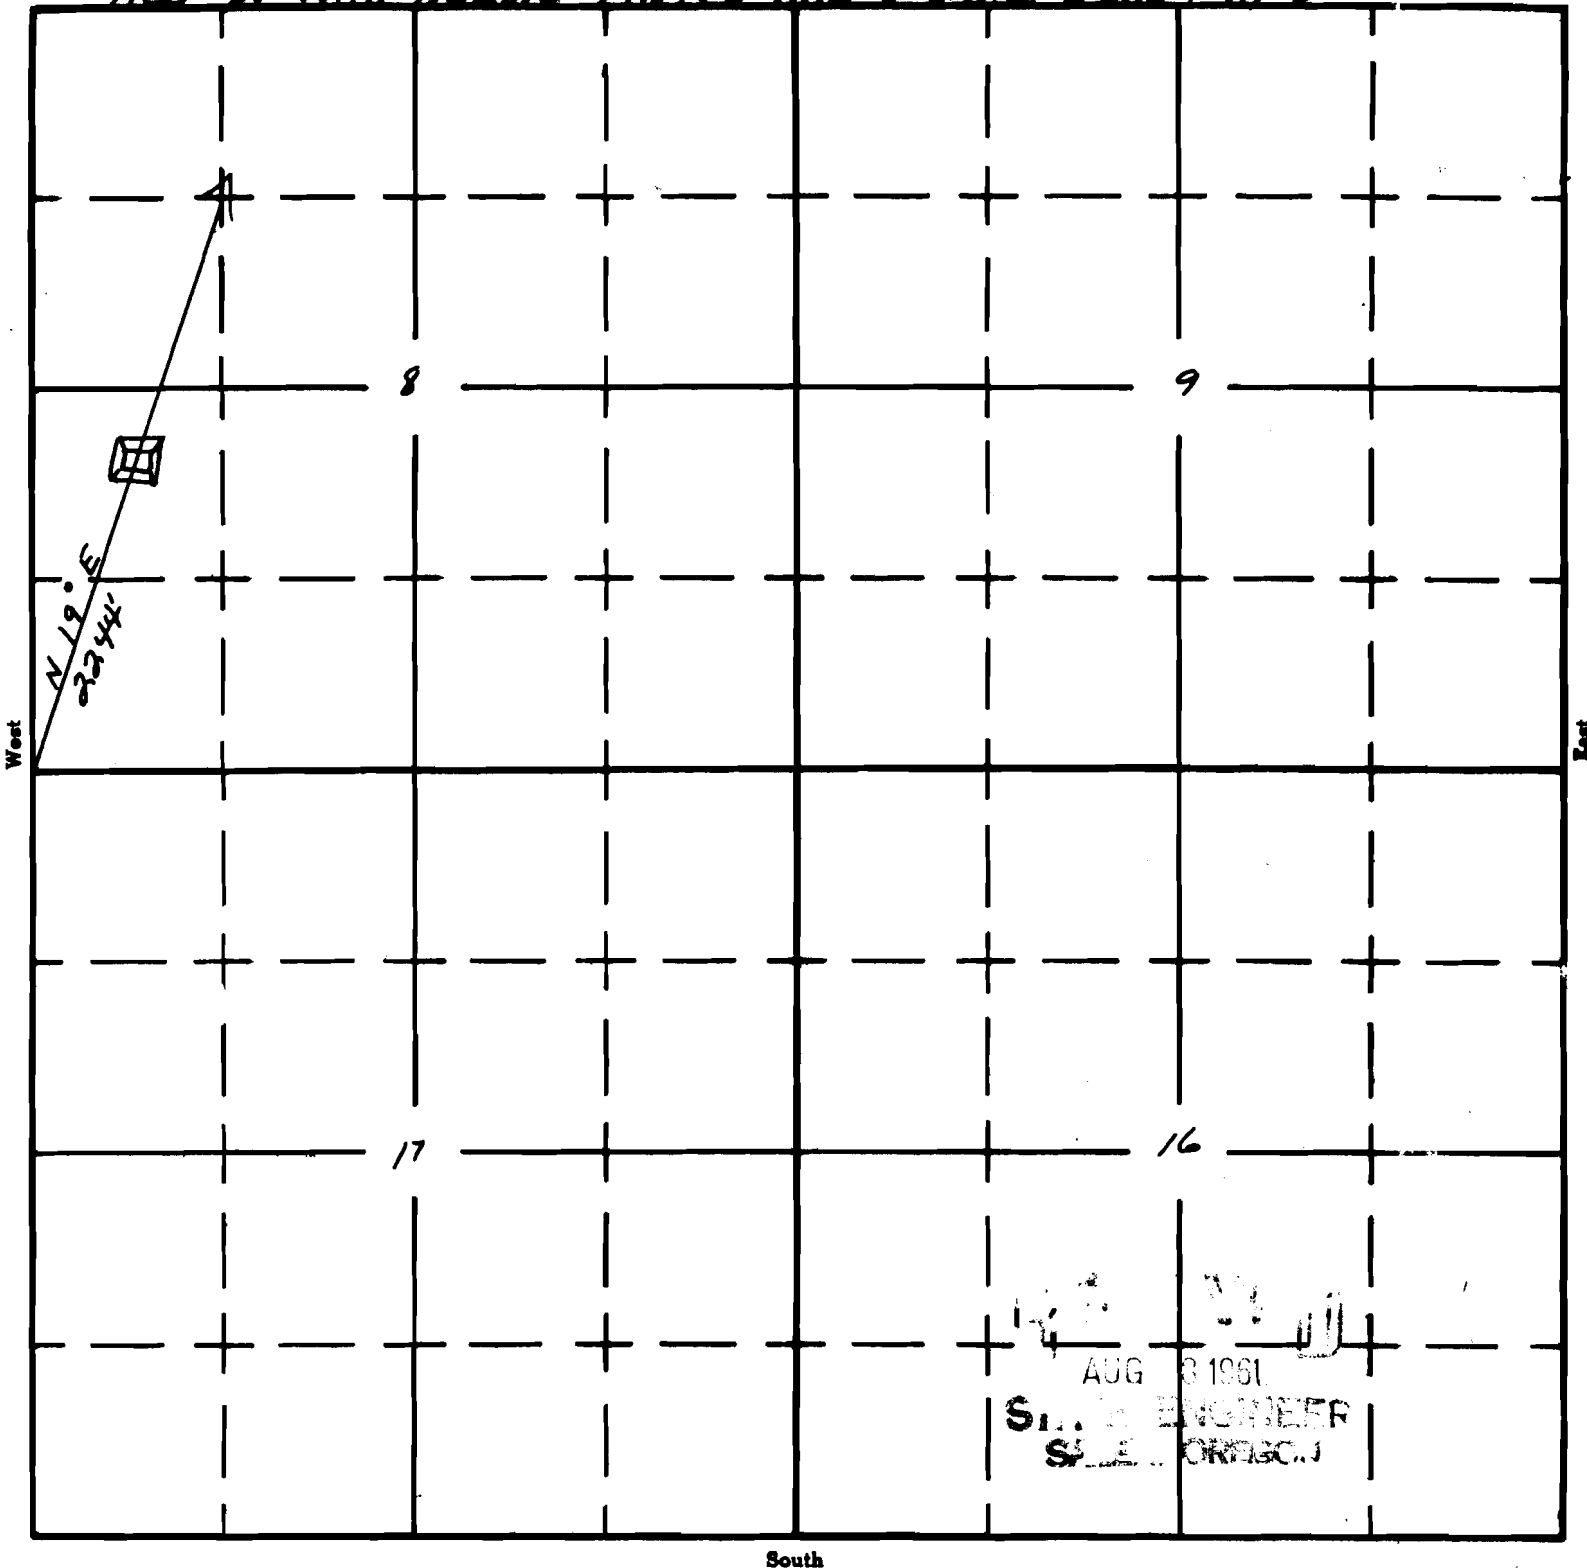

APPLICATION No. R-36412

PERMIT NO. 7035