

Form AI-187
March 1961

UNITED STATES
DEPARTMENT OF THE INTERIOR
BUREAU OF LAND MANAGEMENT

SECTION


8

NW 1/4 SW 1/4

Oregon State Water Filings

TOWNSHIP 30S, RANGE 24E, W. M.

North Tied in with aerial Photo and OSAD Quad Maps

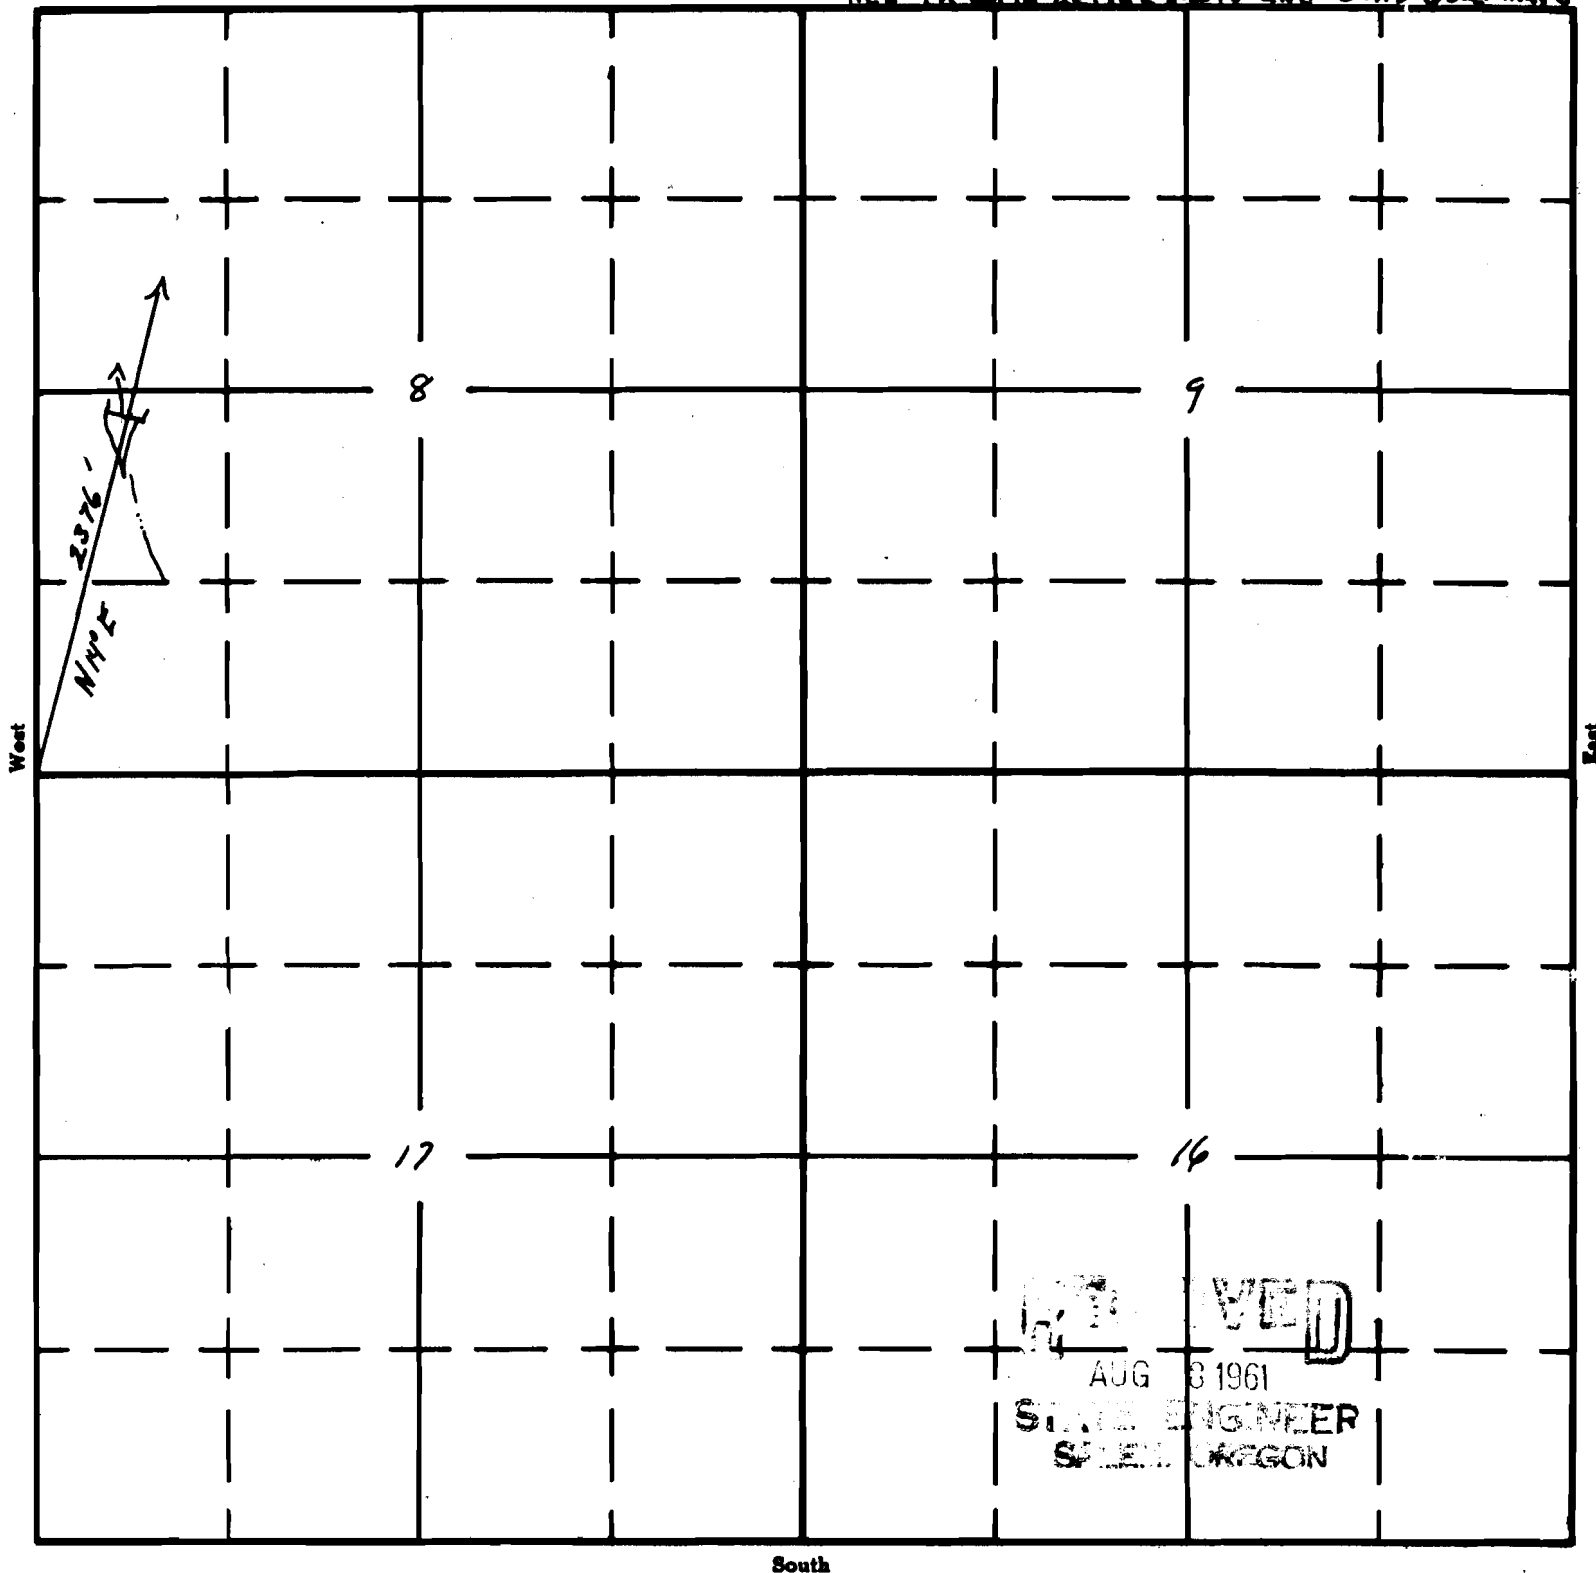

APPLICATION No. R-36349
PERMIT No. 7100