

Form AI-187
March 1961

UNITED STATES
DEPARTMENT OF THE INTERIOR
BUREAU OF LAND MANAGEMENT

SECTION


15

NW 1/4 NW 1/4

Oregon State Water Filings

TOWNSHIP 30S, RANGE 24E, W. M.

North Tied in with aerial Photo and OSD and Maps

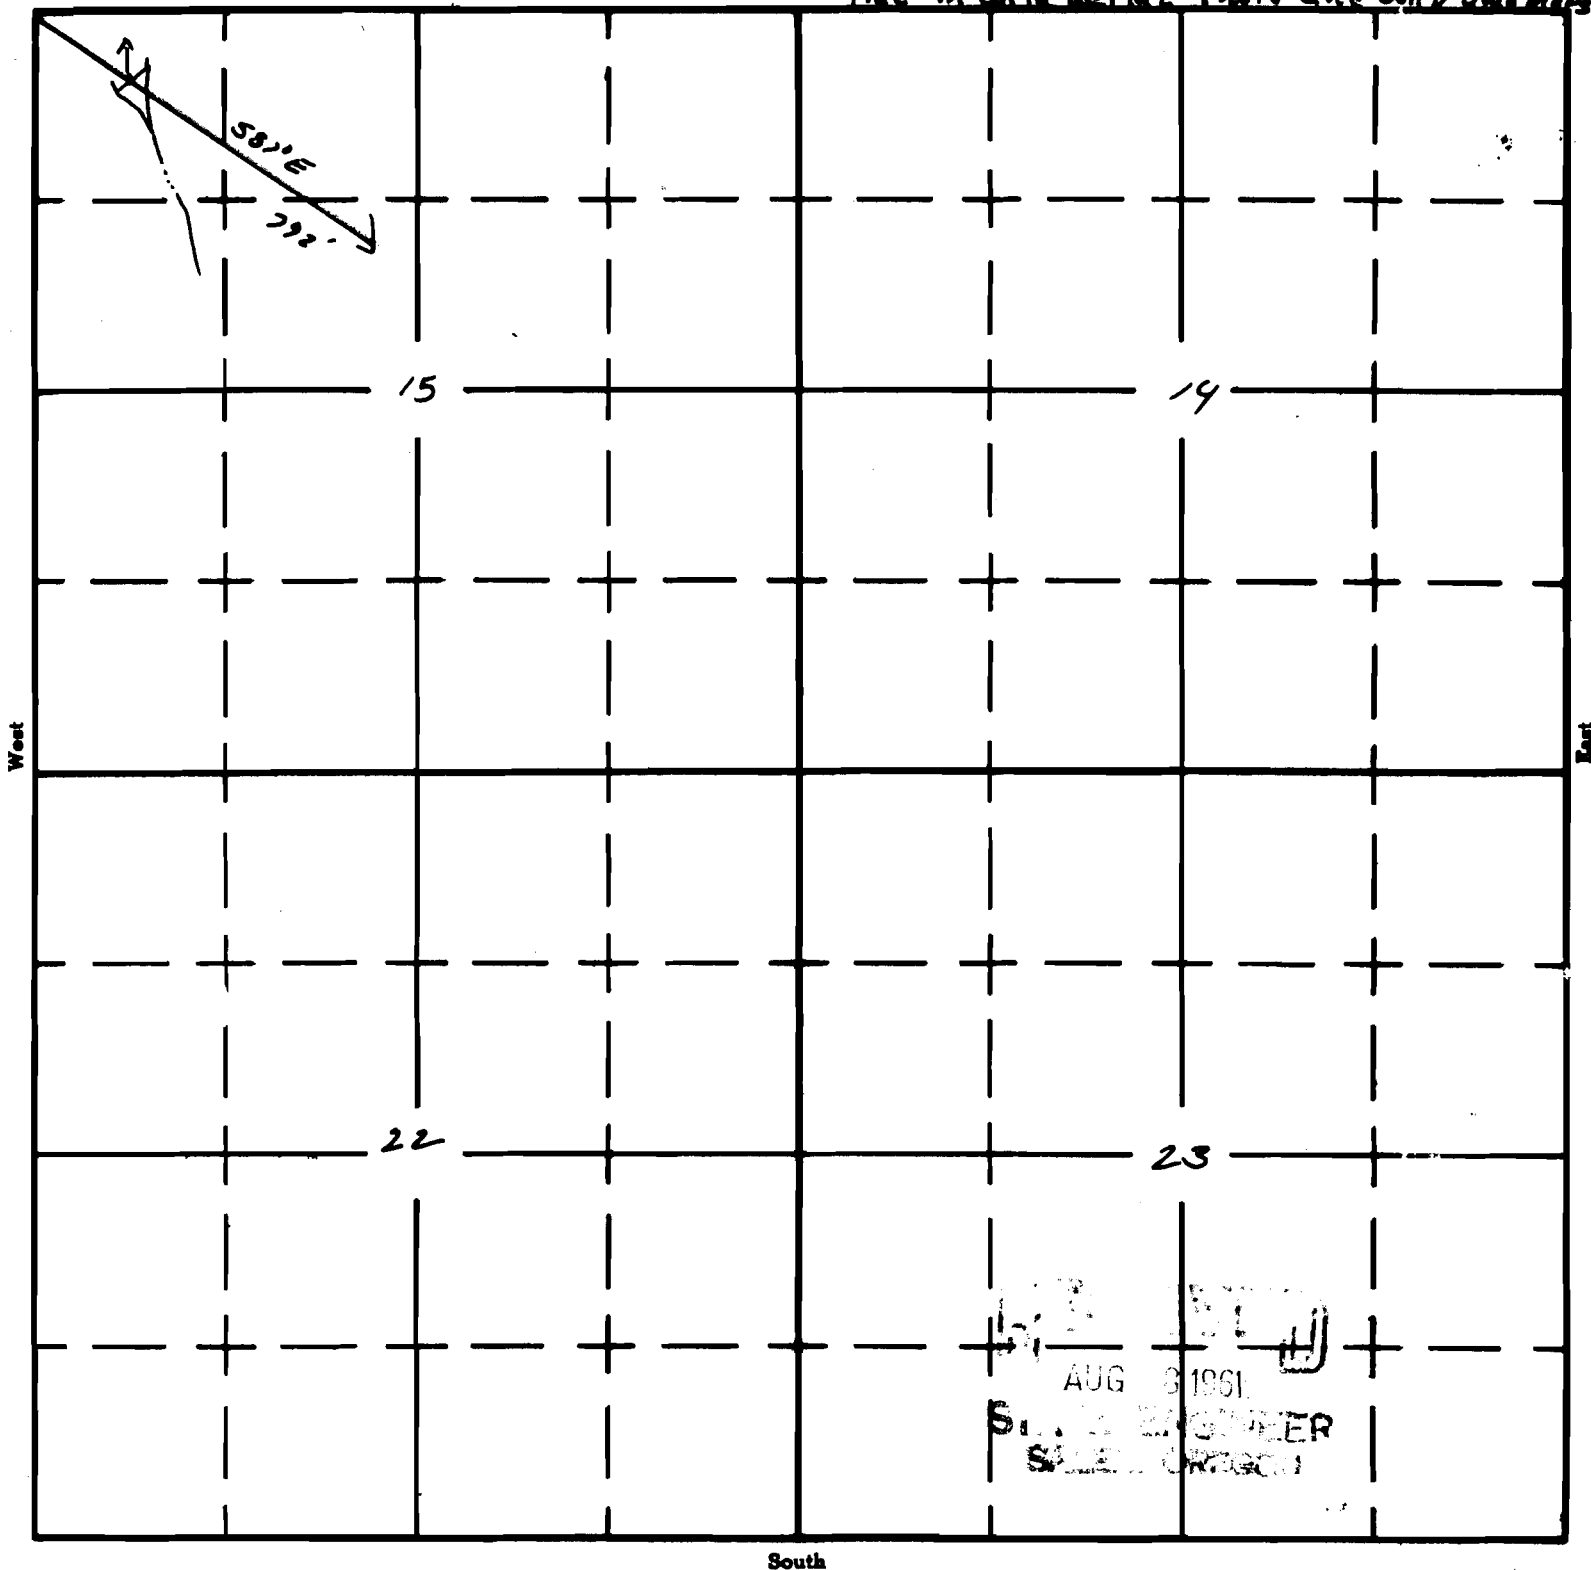

South

AUG 8 1961

APPLICATION No. R-36354
PERMIT No. 7104