

Form A1-187
March 1961


UNITED STATES
DEPARTMENT OF THE INTERIOR
Bureau of Land Management

Section
23

OREGON STATE WATER FILINGS

NW 1/4 NE 1/4

Township 30S, Range 24E, W.M.

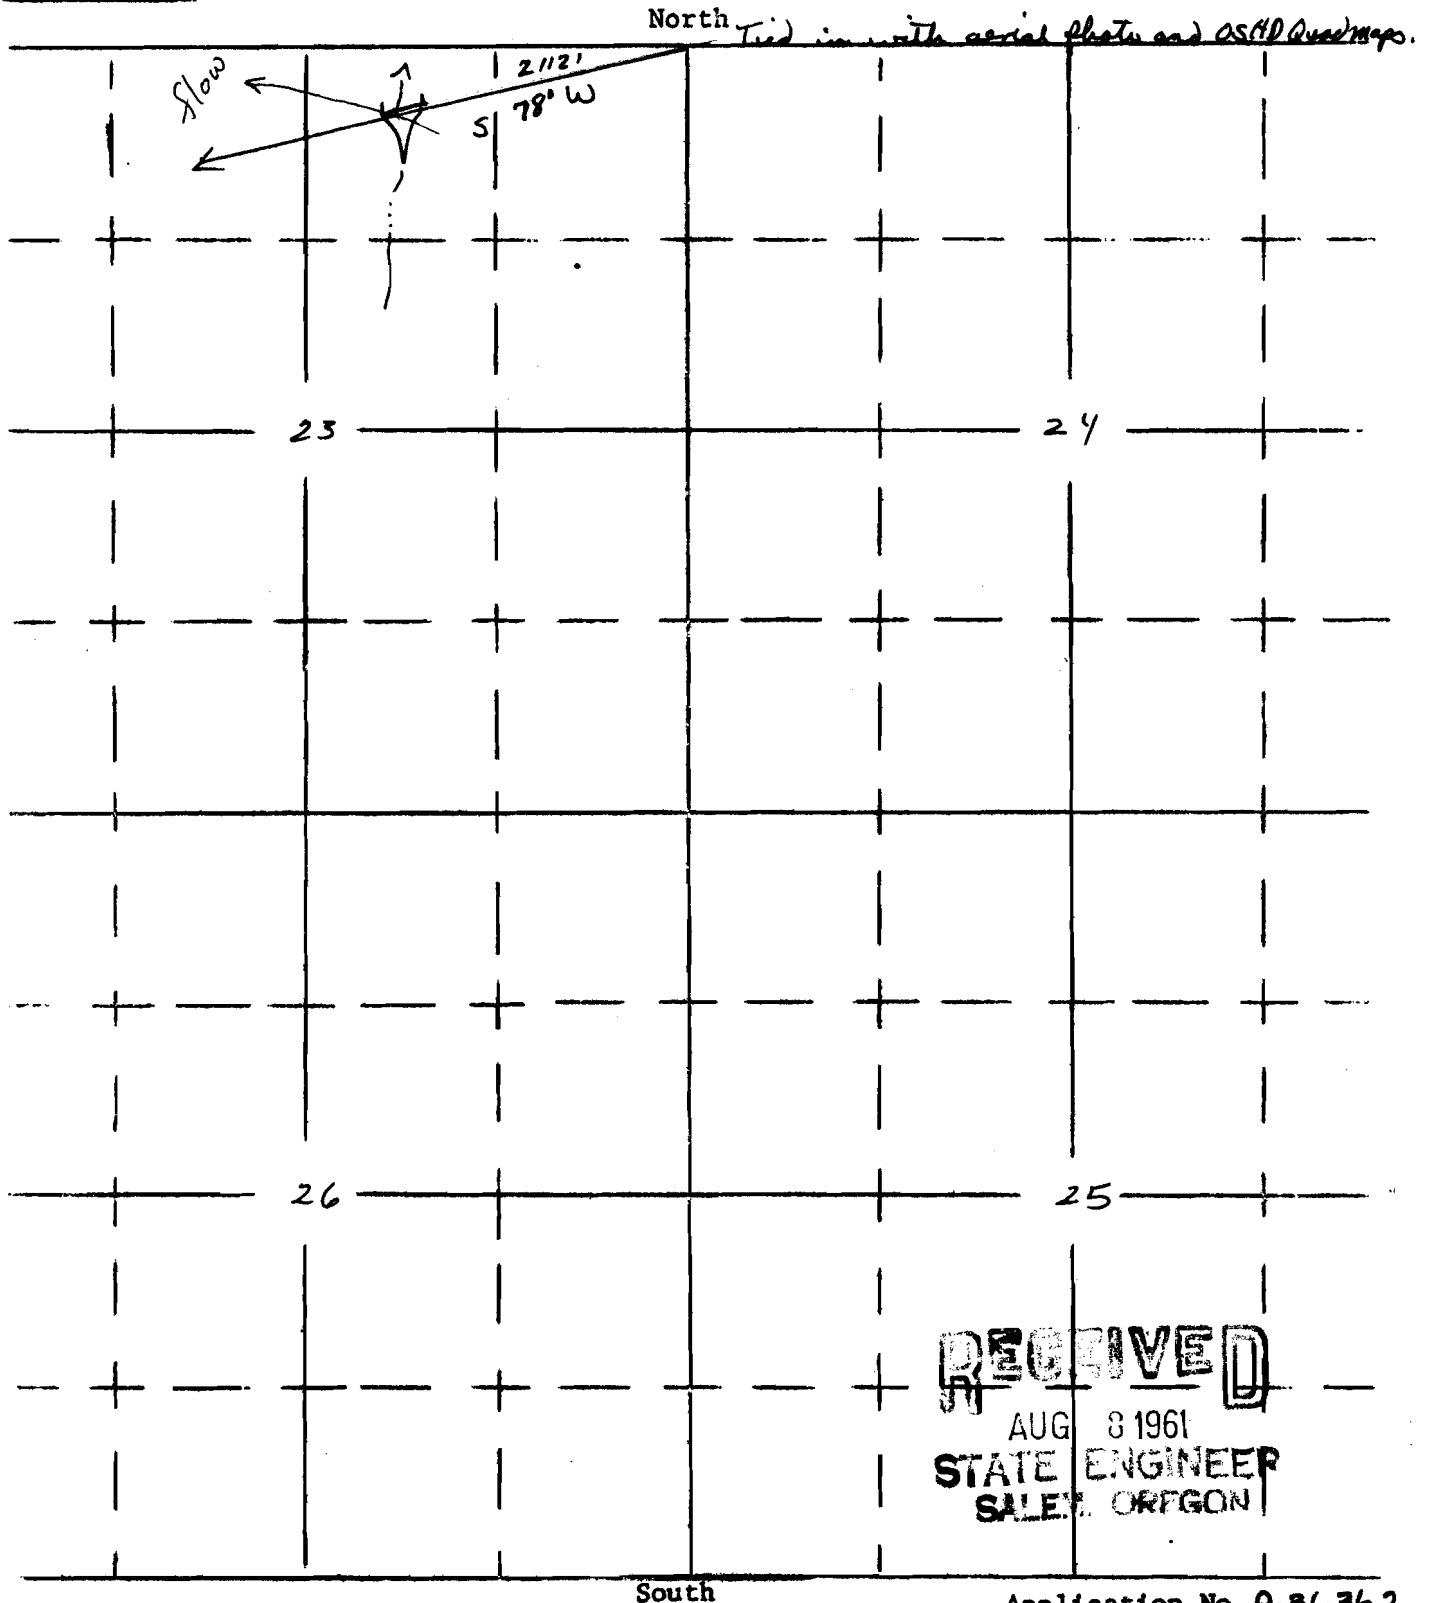

RECEIVED
AUG 8 1961
STATE ENGINEER
SALES OREGON

Application No. R-36362
Permit No. R 7112