

Form AI-187
March 1961

UNITED STATES
DEPARTMENT OF THE INTERIOR
BUREAU OF LAND MANAGEMENT

R-7134
63087


SECTION
30

Oregon State Water Filings

NW 1/4 NW 1/4

TOWNSHIP 36S, RANGE 15E, W. M.

Tied-in with aerial photo : O.S.H.D. Quad Maps

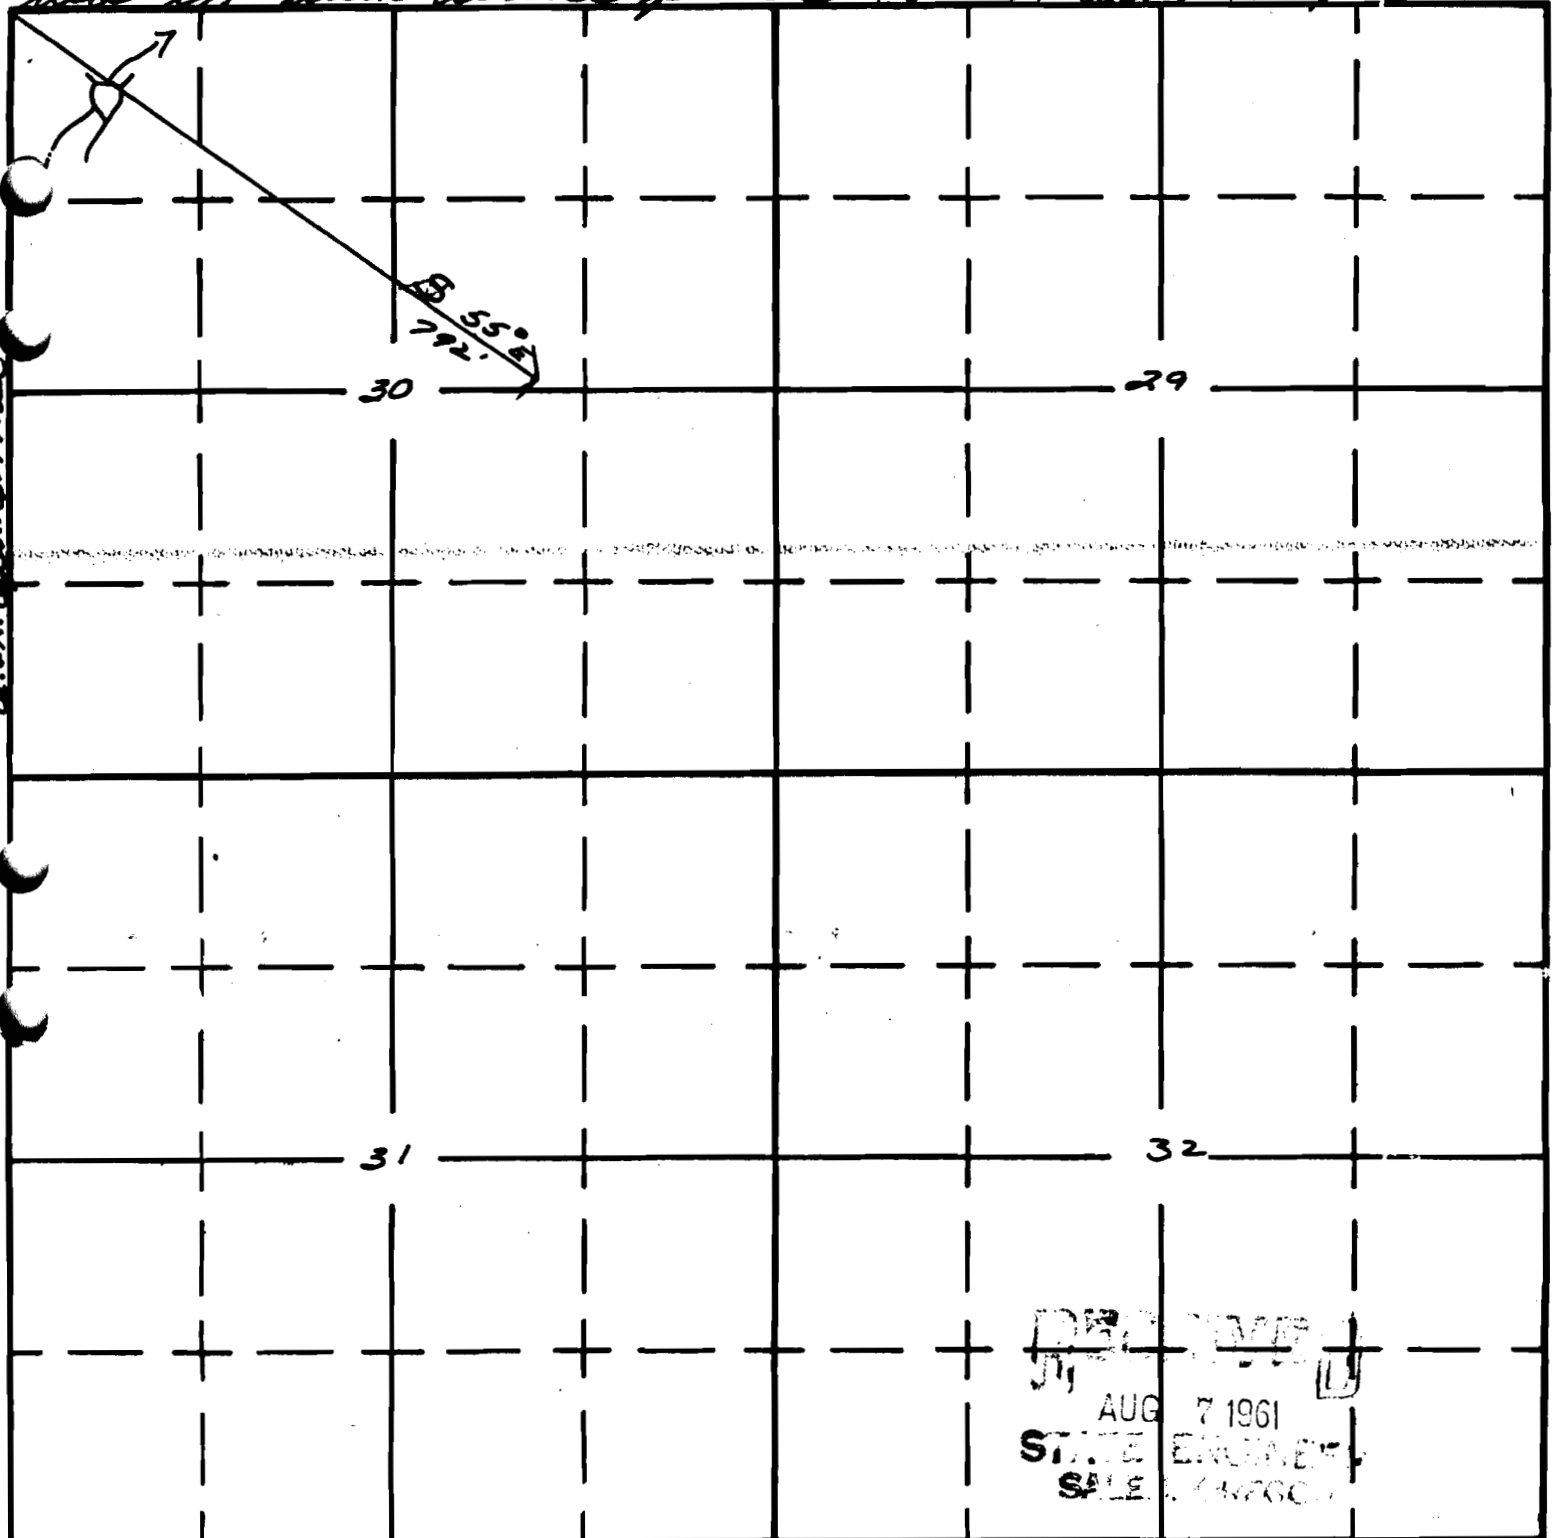

APPLICATION No. R36273
8 7124