

R-7135
63088

Form AI-187
March 1961


UNITED STATES
DEPARTMENT OF THE INTERIOR
BUREAU OF LAND MANAGEMENT


SECTION
32

Oregon State Water Filings

NW 1/4 SE 1/4 TOWNSHIP 36 S, RANGE 15 E, W. M.

Tied-in with Aerial photos & O.S.H.D. Quad Maps

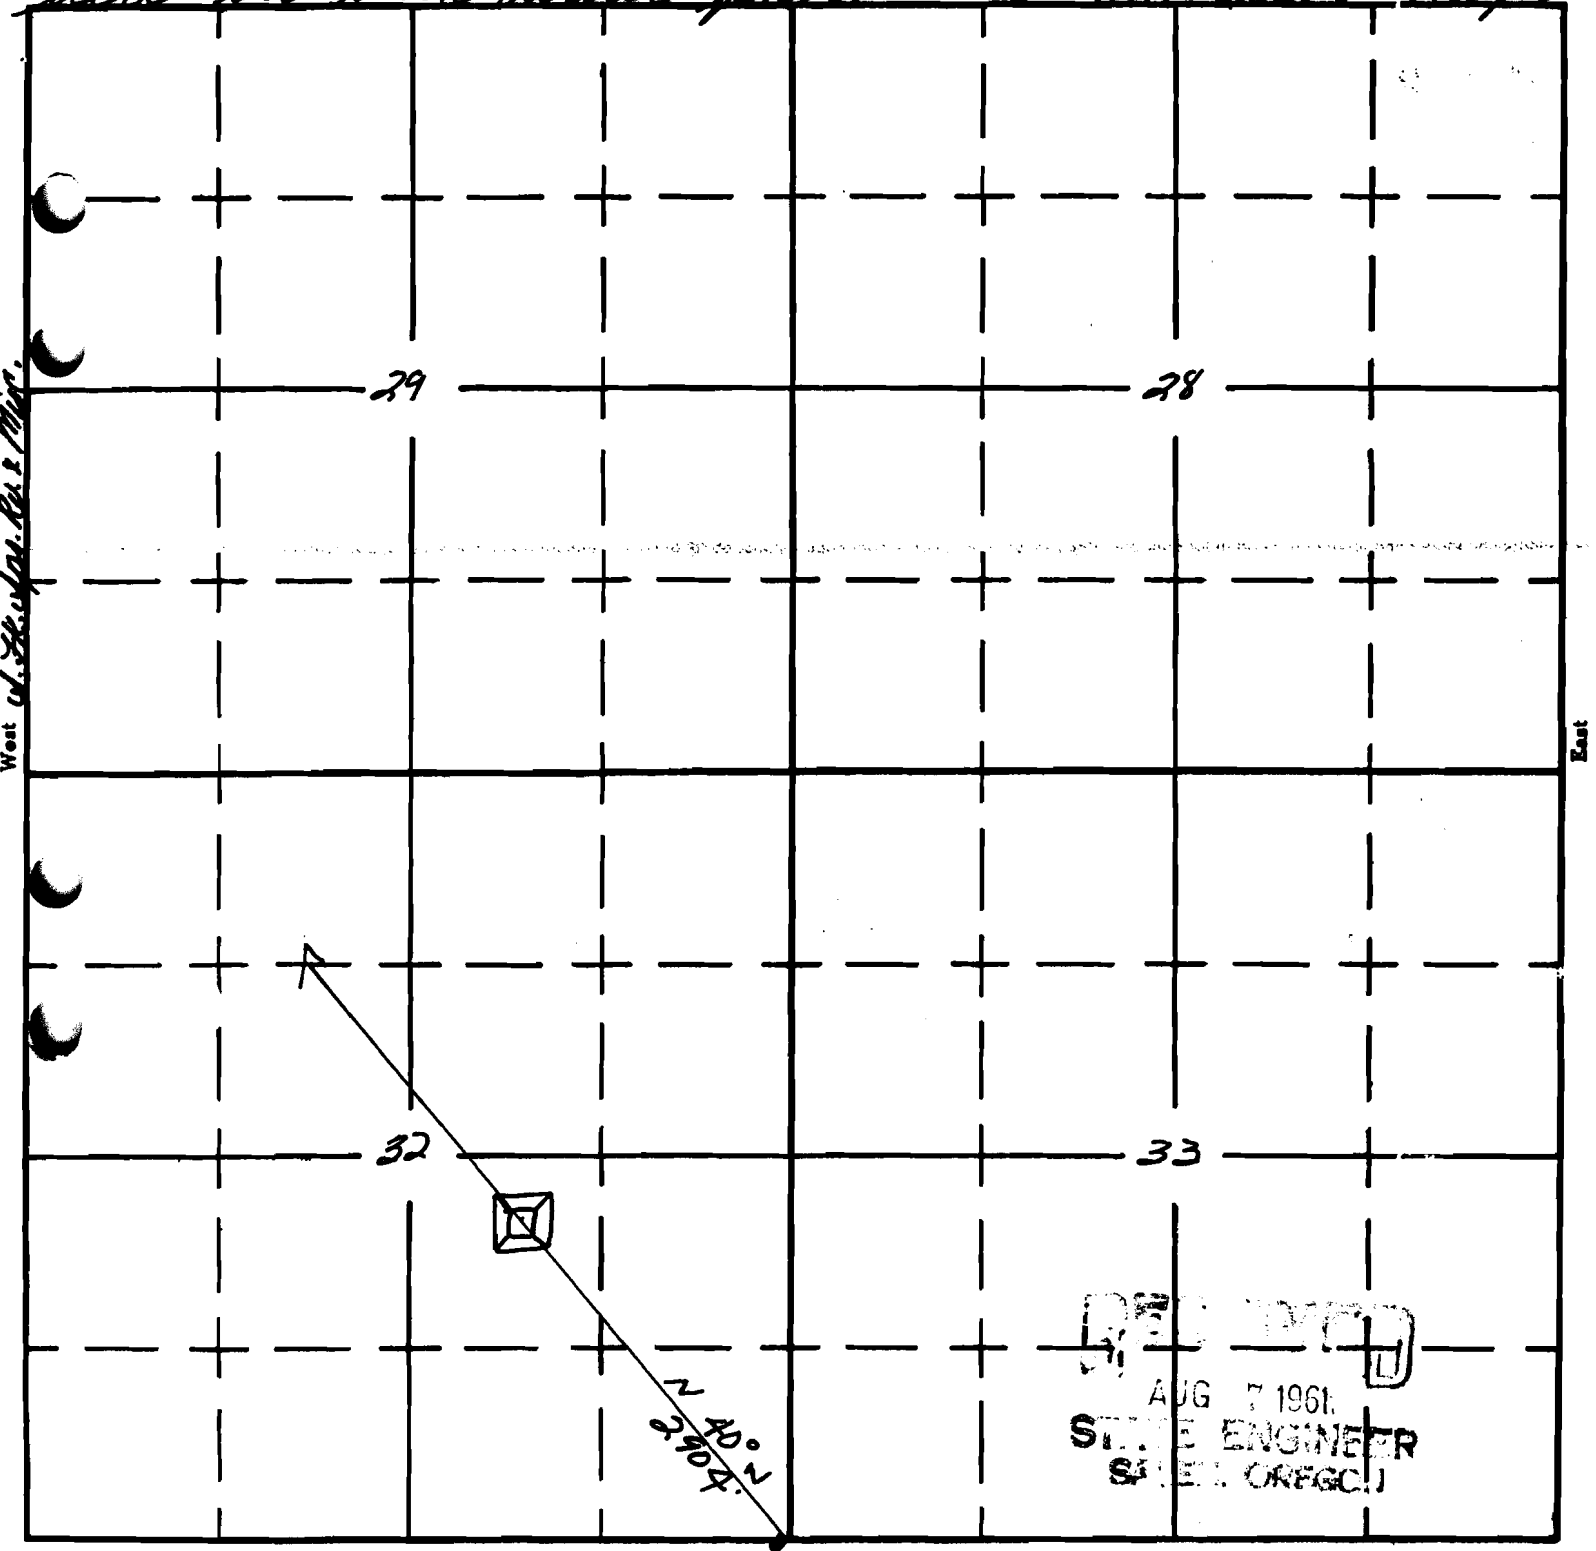

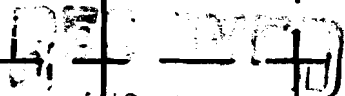
 AUG 7 1961
 STATE ENGINEER
 SALEM, OREGON

APPLICATION No. R-36274
PERMIT NR 7135