

Form AI-187
March 1961

UNITED STATES
DEPARTMENT OF THE INTERIOR
BUREAU OF LAND MANAGEMENT

R-7136
63089

SECTION

Oregon State Water Filings


Sec. 4

SW 1/4, SW 1/4

TOWNSHIP 37S, RANGE 15E, W. M.

North

A. Lk. Sprague Riv. & Misc.

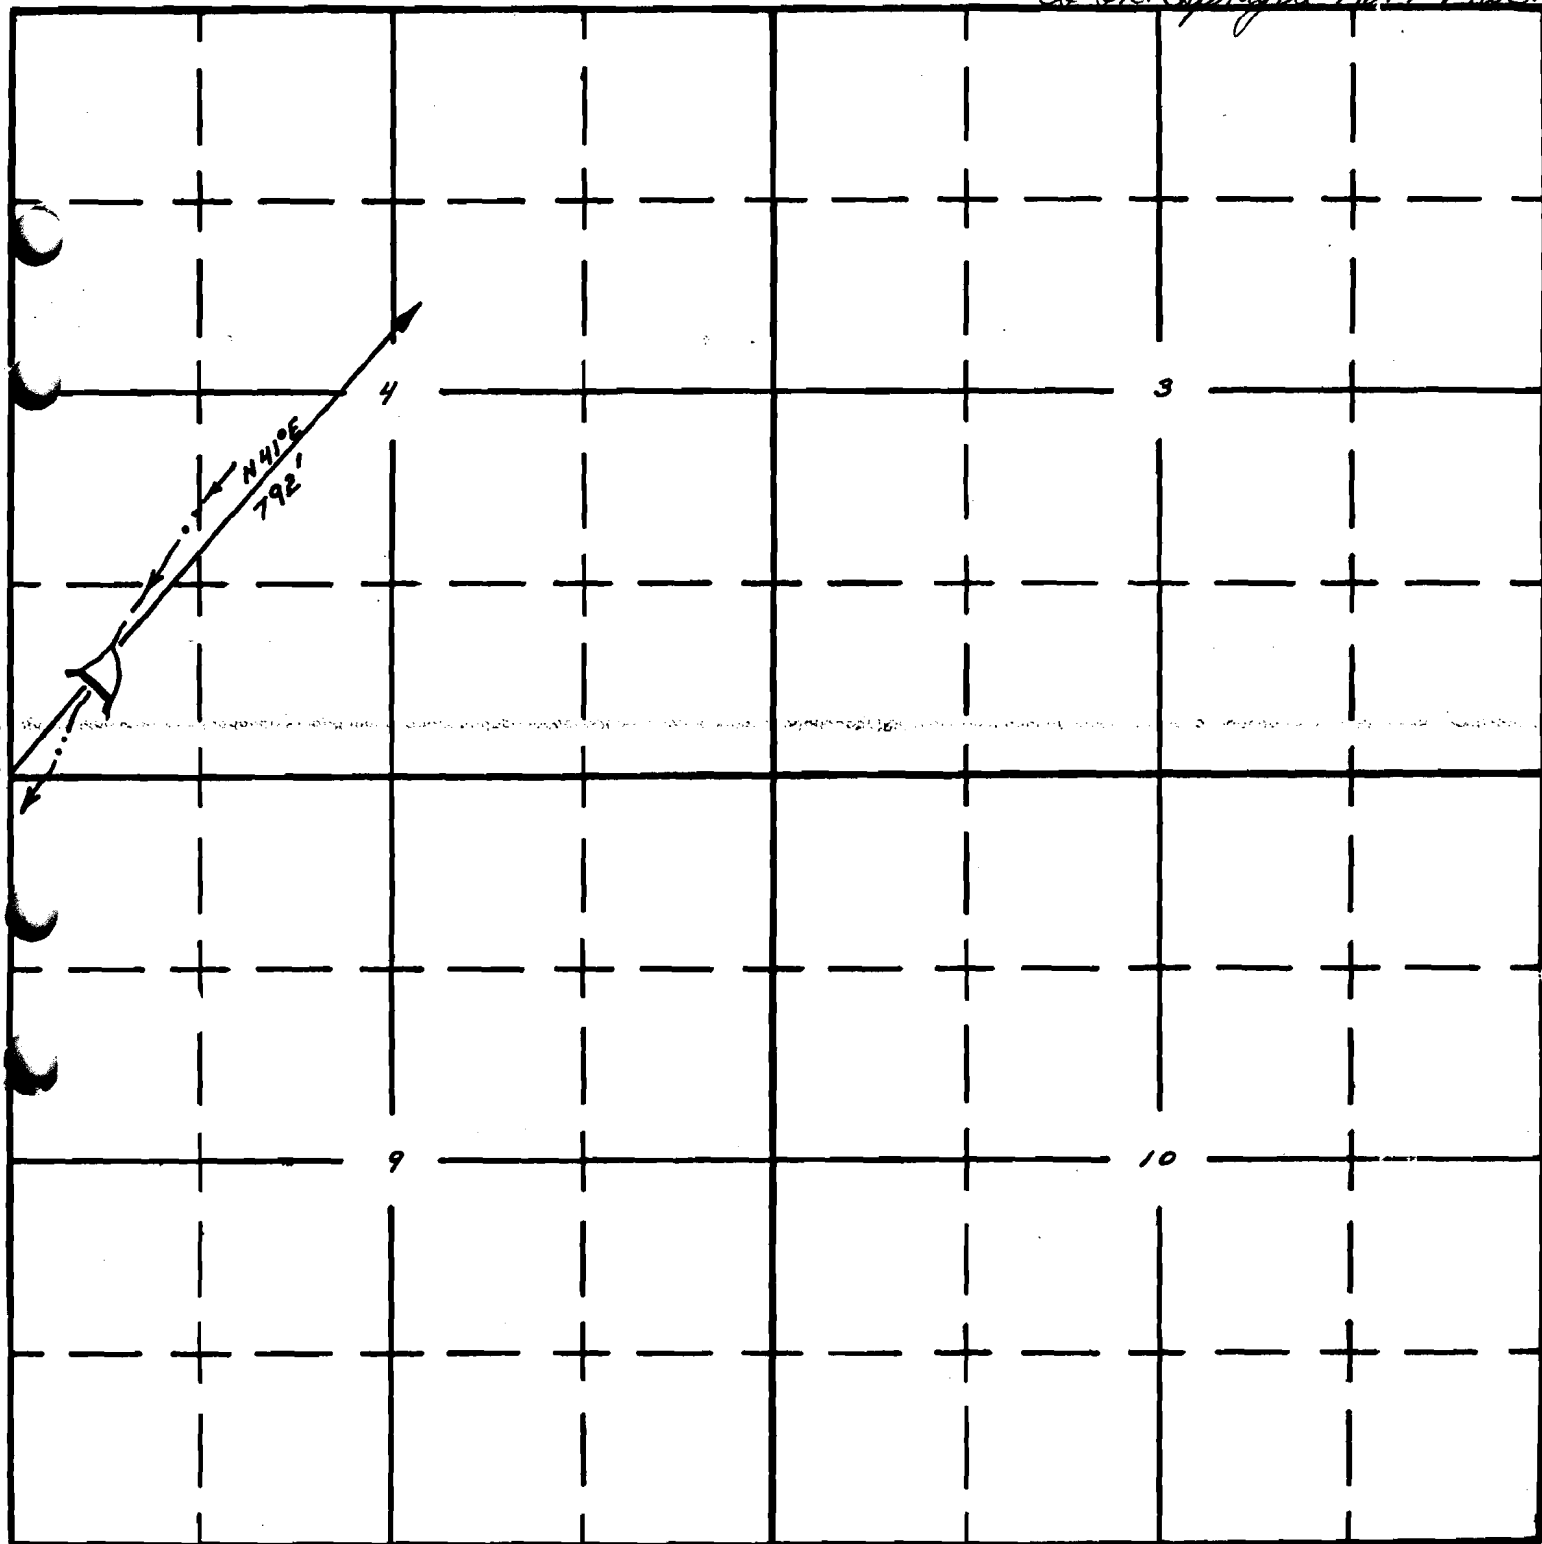

Bell Sec. 15 Waterhole

0-1-153

South

APPLICATION No. A36275
PERMIT No. 7136