

R-7138
63090

Form A1-187
March 1961

UNITED STATES
DEPARTMENT OF THE INTERIOR
BUREAU OF LAND MANAGEMENT


SECTION

Oregon State Water Filings

10 9
NW 1/4 NW 1/4
NE 1/4 NE 1/4

TOWNSHIP 41S, RANGE 14E, W. M.

North Tied in with aerial Photo and OSTRD Quad Maps.

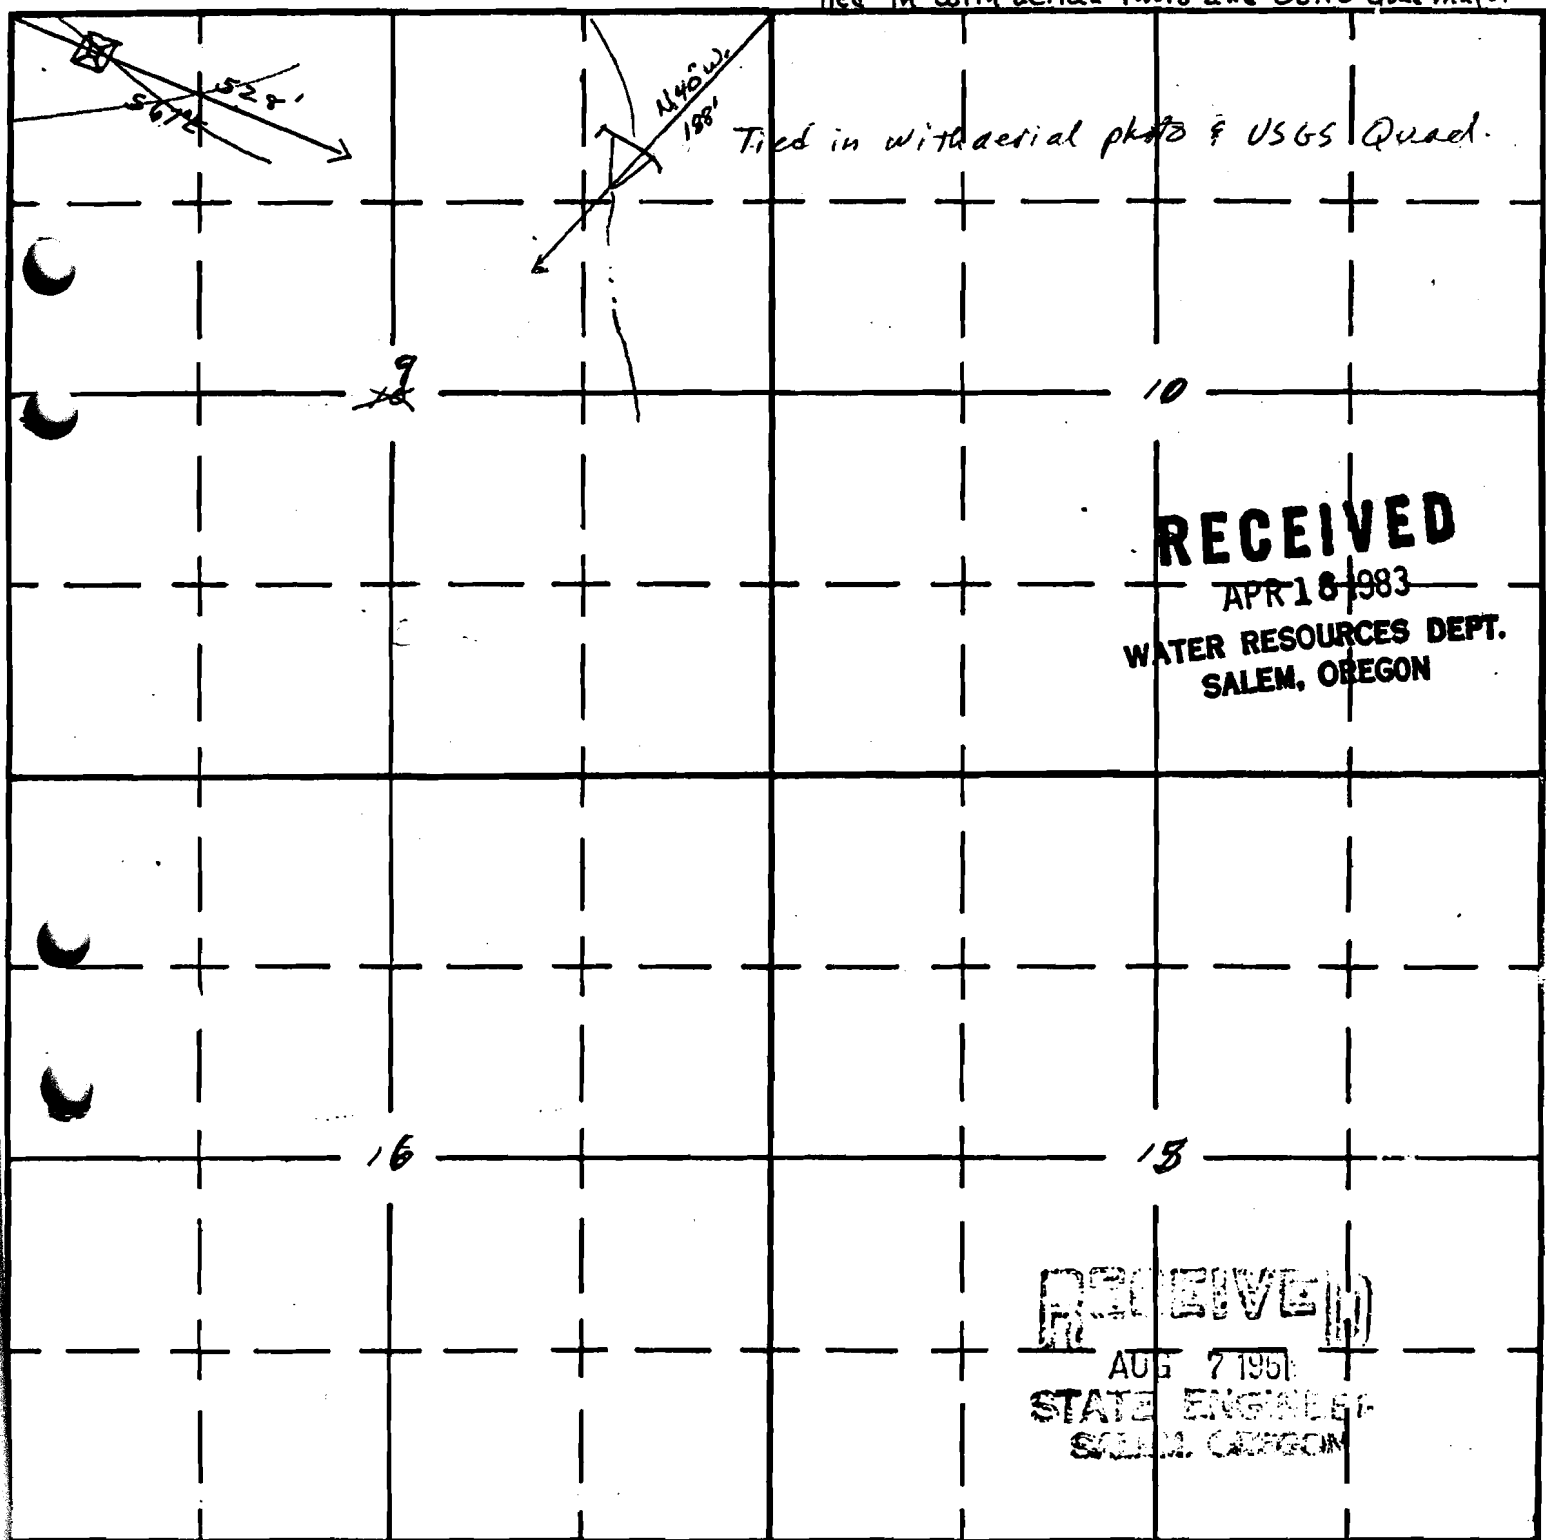

South

E. B. Lott Rev. & Misc.

APPLICATION No. R-36301
PERMIT No. R 7138