

Form AI-187
March 1961

UNITED STATES
DEPARTMENT OF THE INTERIOR
BUREAU OF LAND MANAGEMENT

R-7139
63091

SECTION

9


SE $\frac{1}{4}$ SW $\frac{1}{4}$

Oregon State Water Filings

TOWNSHIP $41S$, RANGE $14\frac{1}{2}E$, W. M.

E. Branch Lost Riv. & Misc.

North Tied in with aerial Photo and USHD Quad Maps

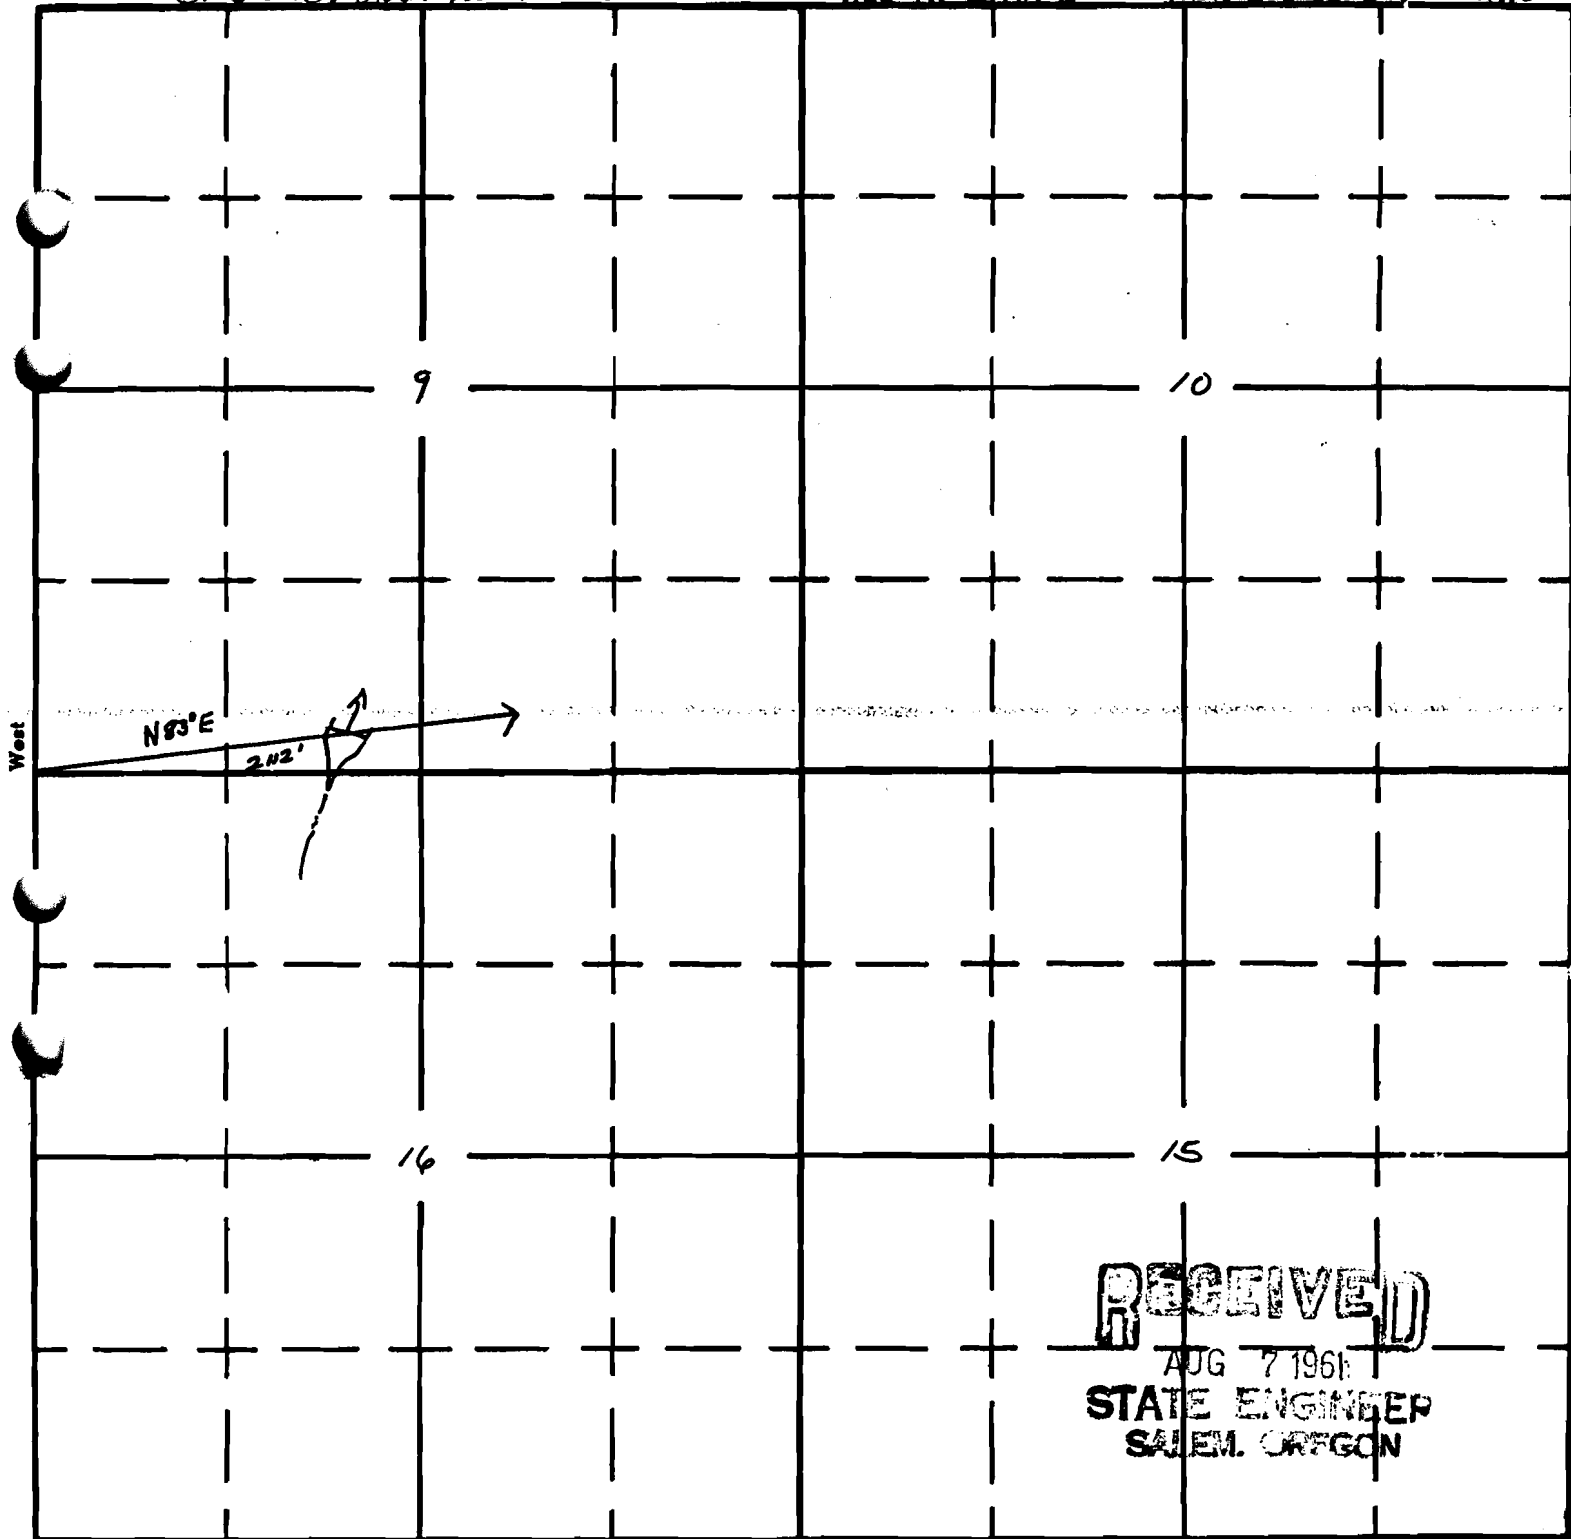

RECEIVED
AUG 7 1961
STATE ENGINEER
SALEM, OREGON

South

APPLICATION No. R-36302
PERMIT No. **7139**