

Form AI-187
March 1961

UNITED STATES
DEPARTMENT OF THE INTERIOR
BUREAU OF LAND MANAGEMENT


A-7145
63093

SECTION 14

Oregon State Water Filings

NW 1/4 NE 1/4 TOWNSHIP 40 S, RANGE 14 1/2 E, W. M.

Tied in with aerial photos & O.S.H.D. Quad Maps

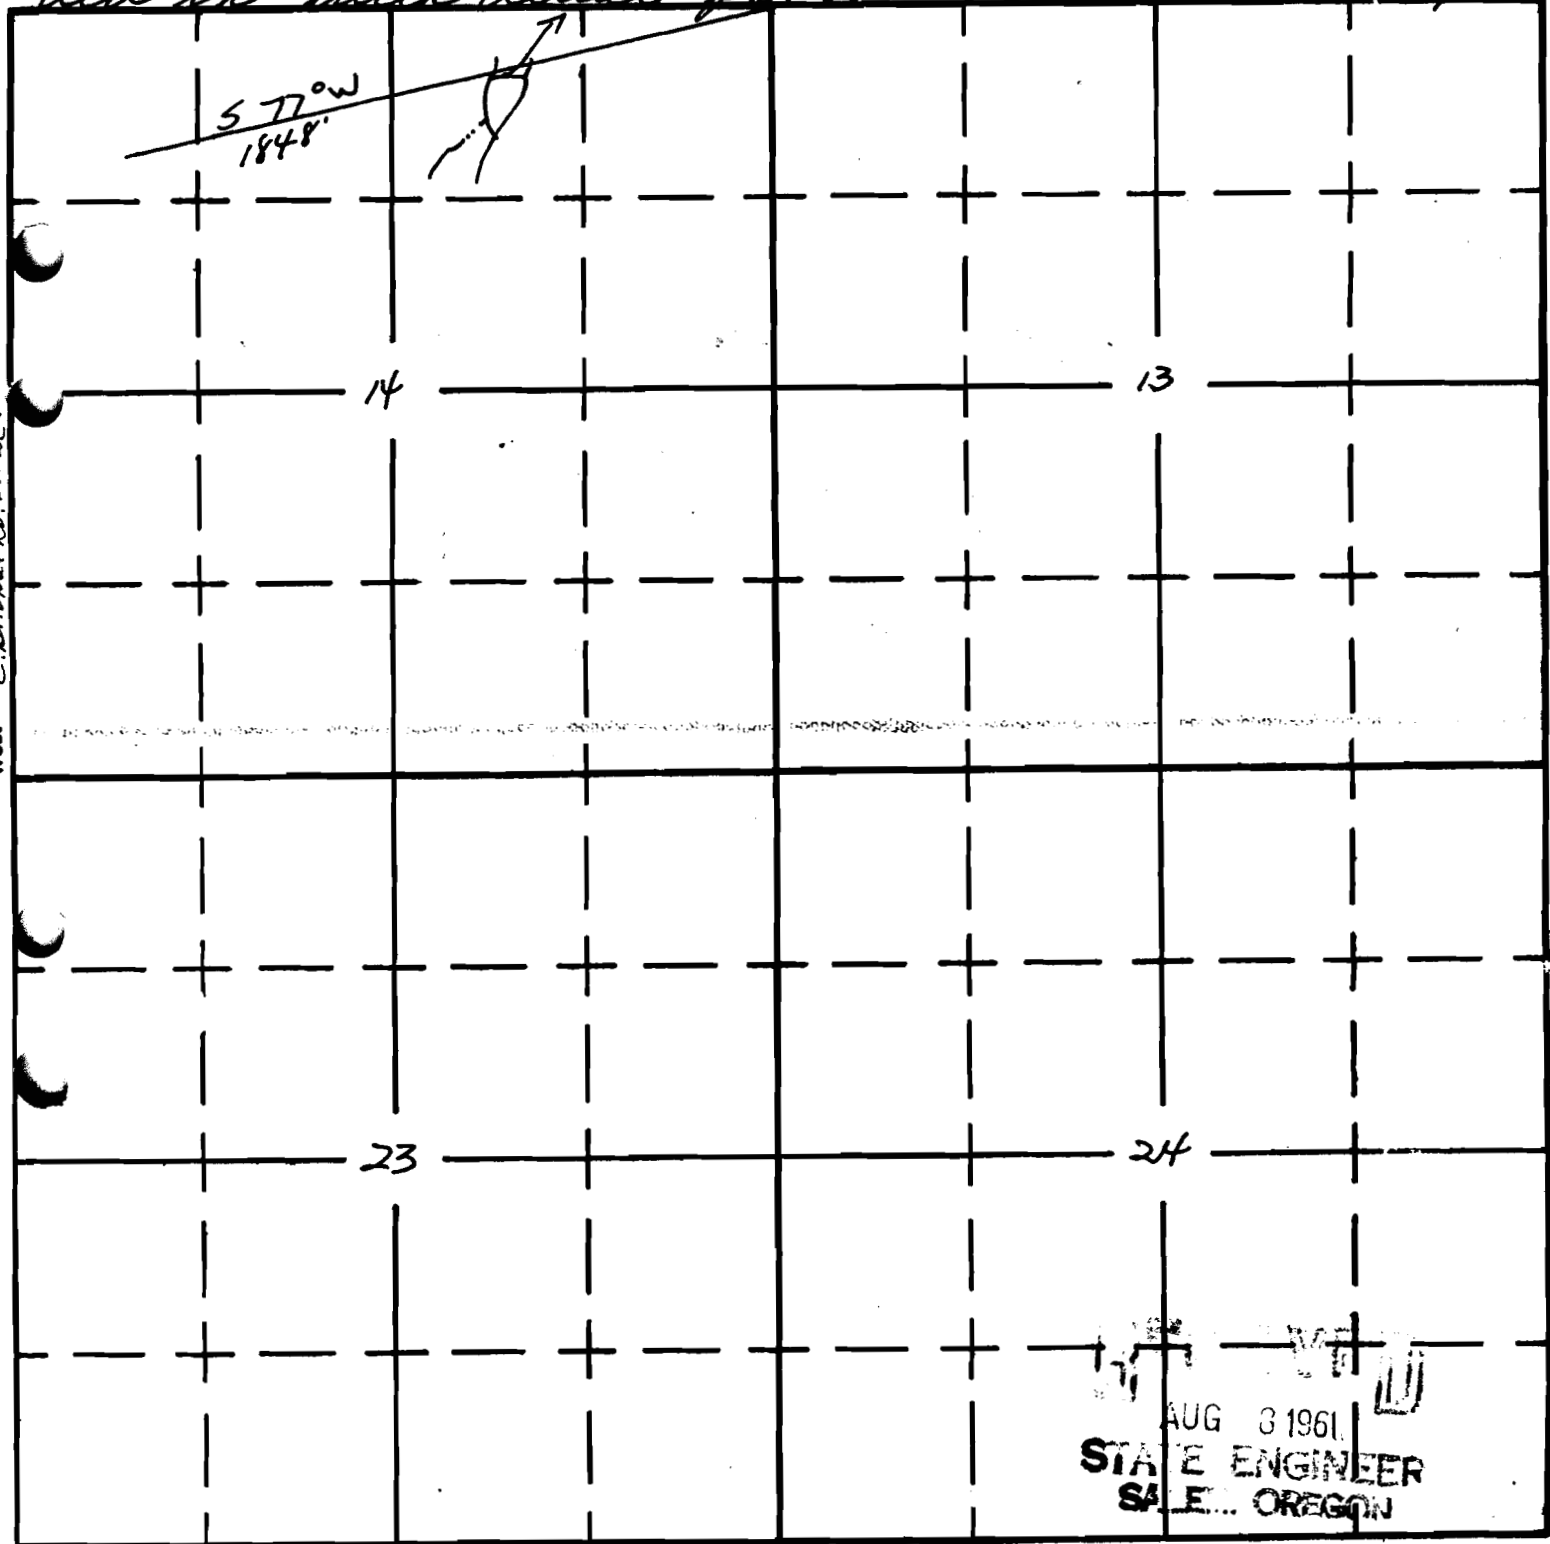

AUG 3 1961
STATE ENGINEER
SALE OREGON

APPLICATION No. R-36405
PERMIT No. R 7145