

R-7374

63100

Form AI-187
March 1961UNITED STATES
DEPARTMENT OF THE INTERIOR
BUREAU OF LAND MANAGEMENT


SECTION

7

Oregon State Water Filings

SW 1/4 SE 1/4TOWNSHIP 39S, RANGE 26E, W. M.

North

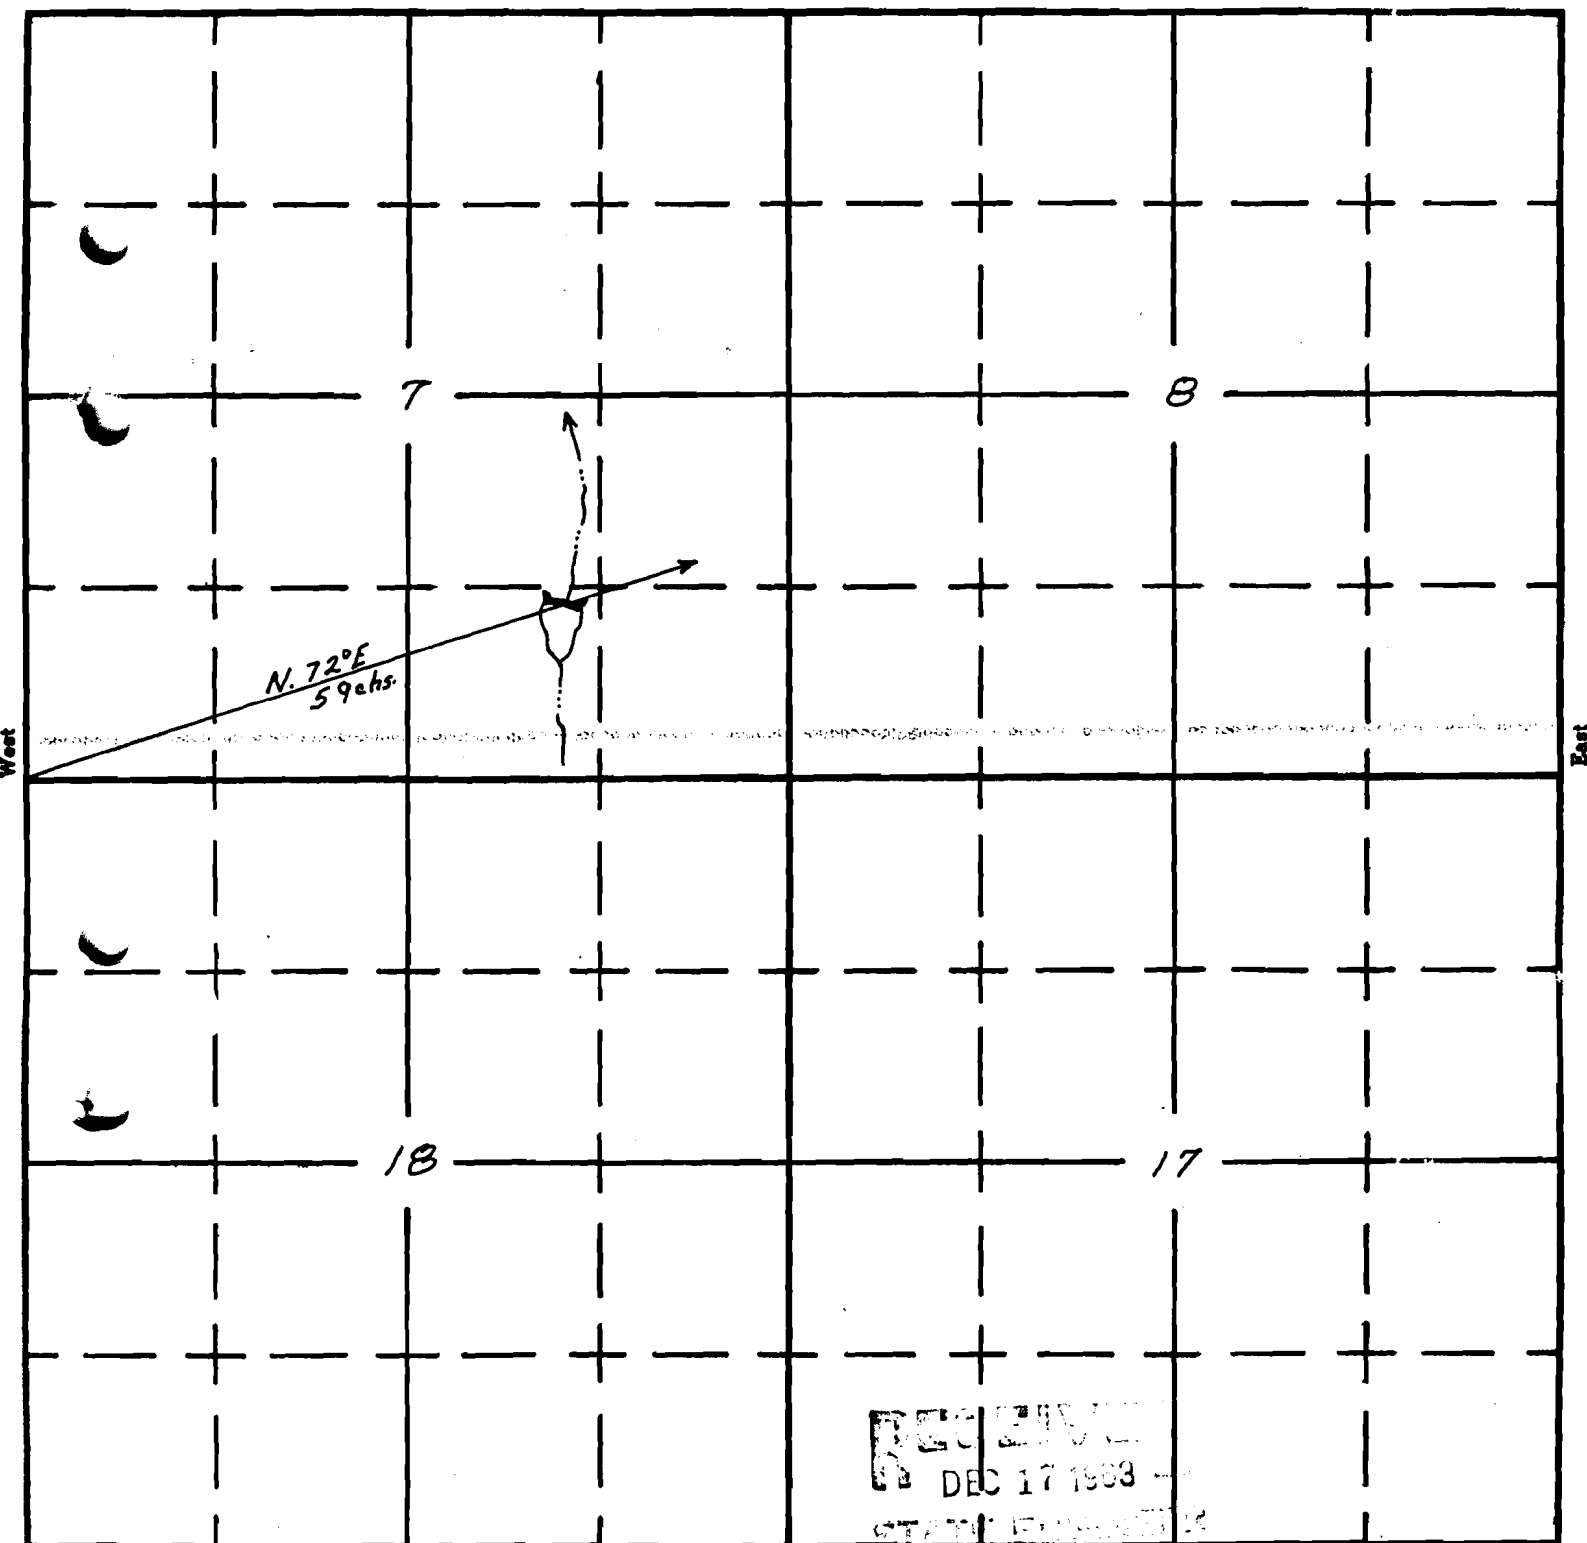

South

RECEIVED
DEC 17 1968



Mud Lake Res. #4

01-R-167

APPLICATION No. **R-39309**
PERMIT No. **R-7374**