


Form AI-187
March 1961

UNITED STATES
DEPARTMENT OF THE INTERIOR
BUREAU OF LAND MANAGEMENT

R-7375
63101

SECTION 7 **Oregon State Water Filings**

NW 1/4 NE 1/4 TOWNSHIP 39S, RANGE 26E, W. M.

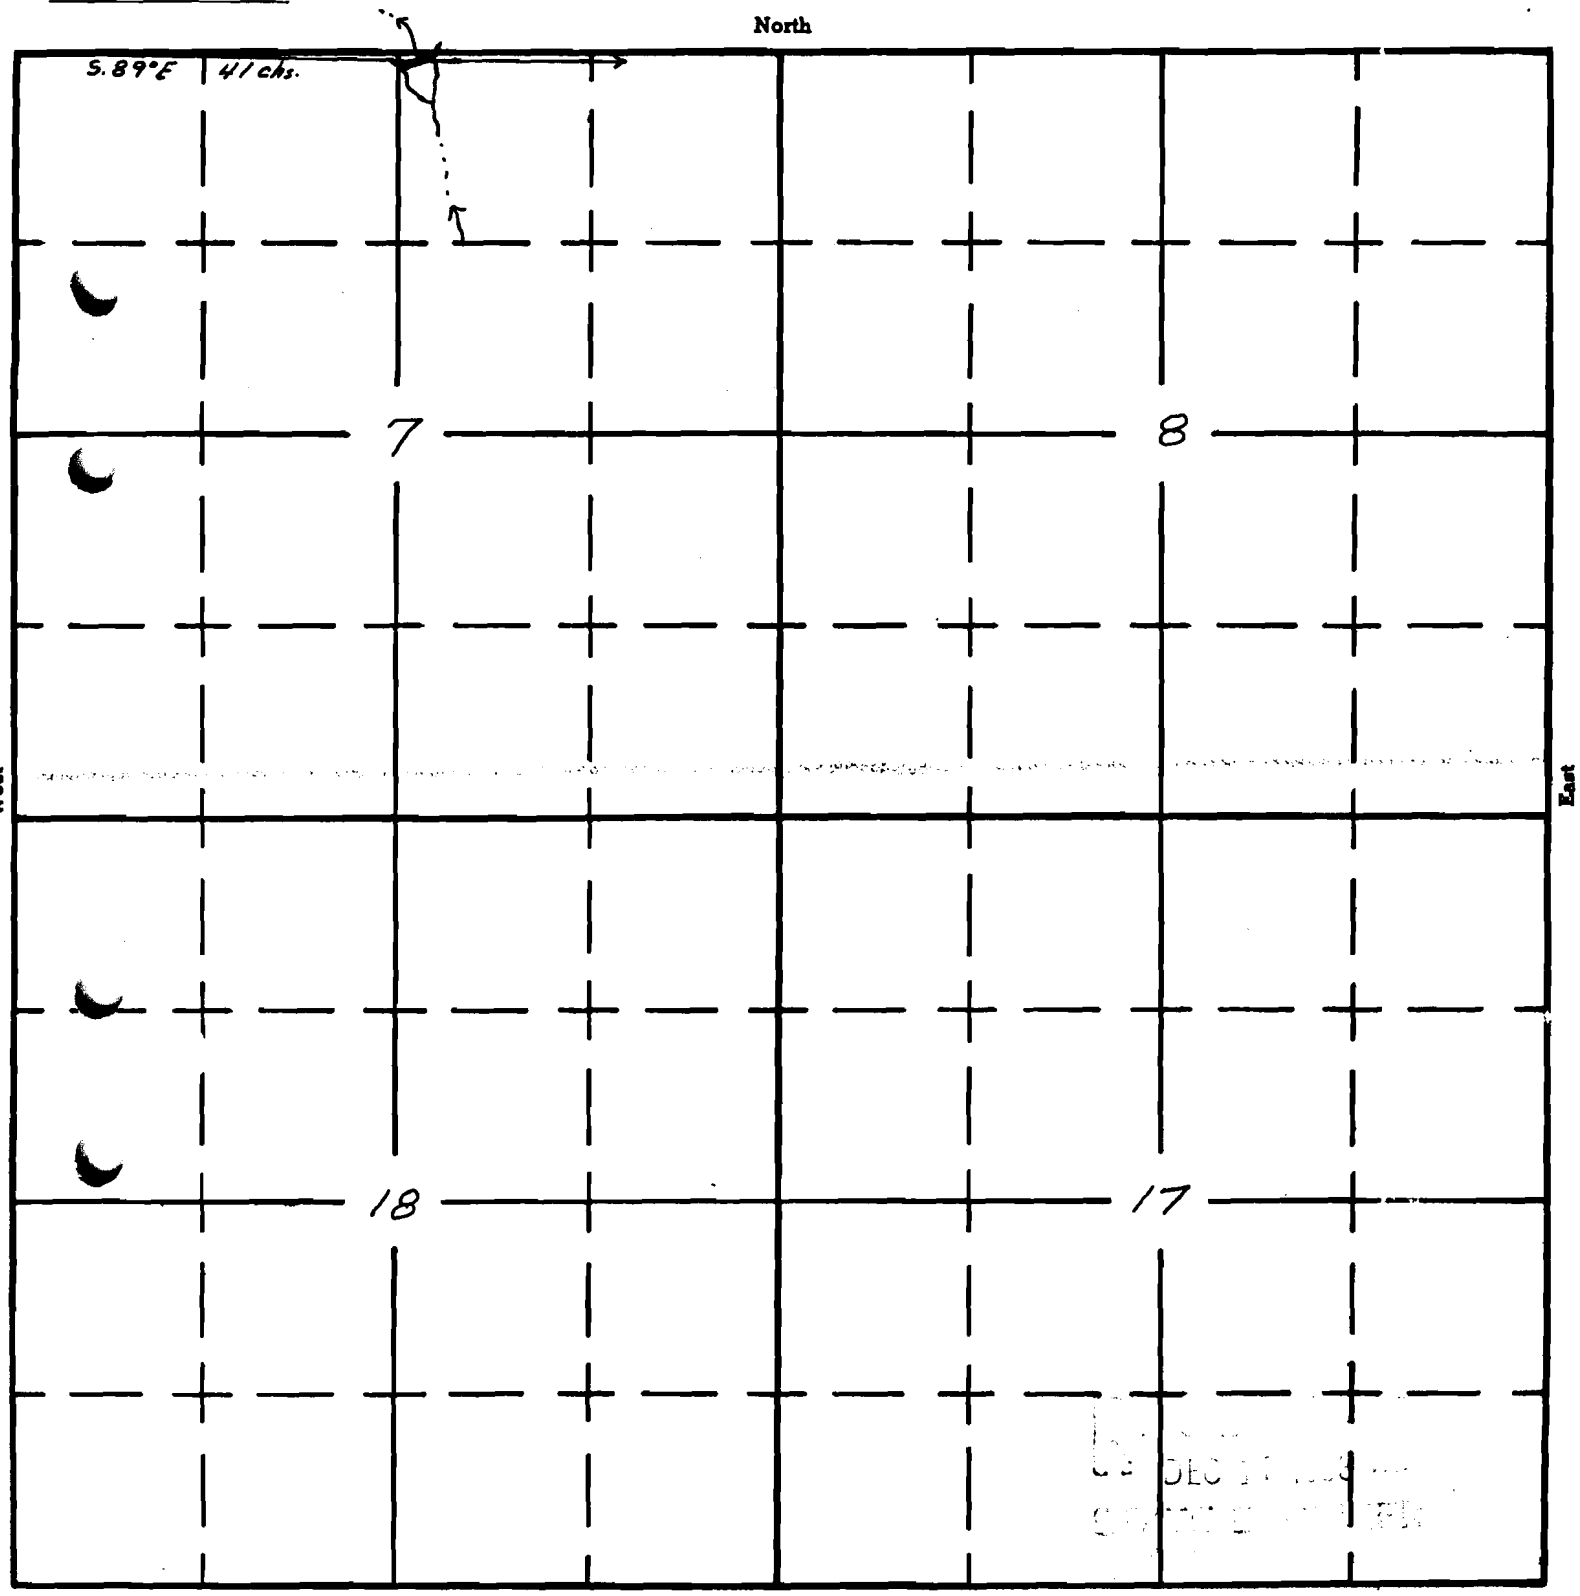

Mud Lake Res. #3
01-R-166

APPLICATION No. **R-39309**
PERMIT No. **R 7375**