

P-7114-1
Nov. 1965

UNITED STATES
DEPARTMENT OF THE INTERIOR
BUREAU OF LAND MANAGEMENT


SECTION

Oregon State Water Filings

22
SW⁴SW⁴

TOWNSHIP 39S., RANGE 23E, W. M.

North

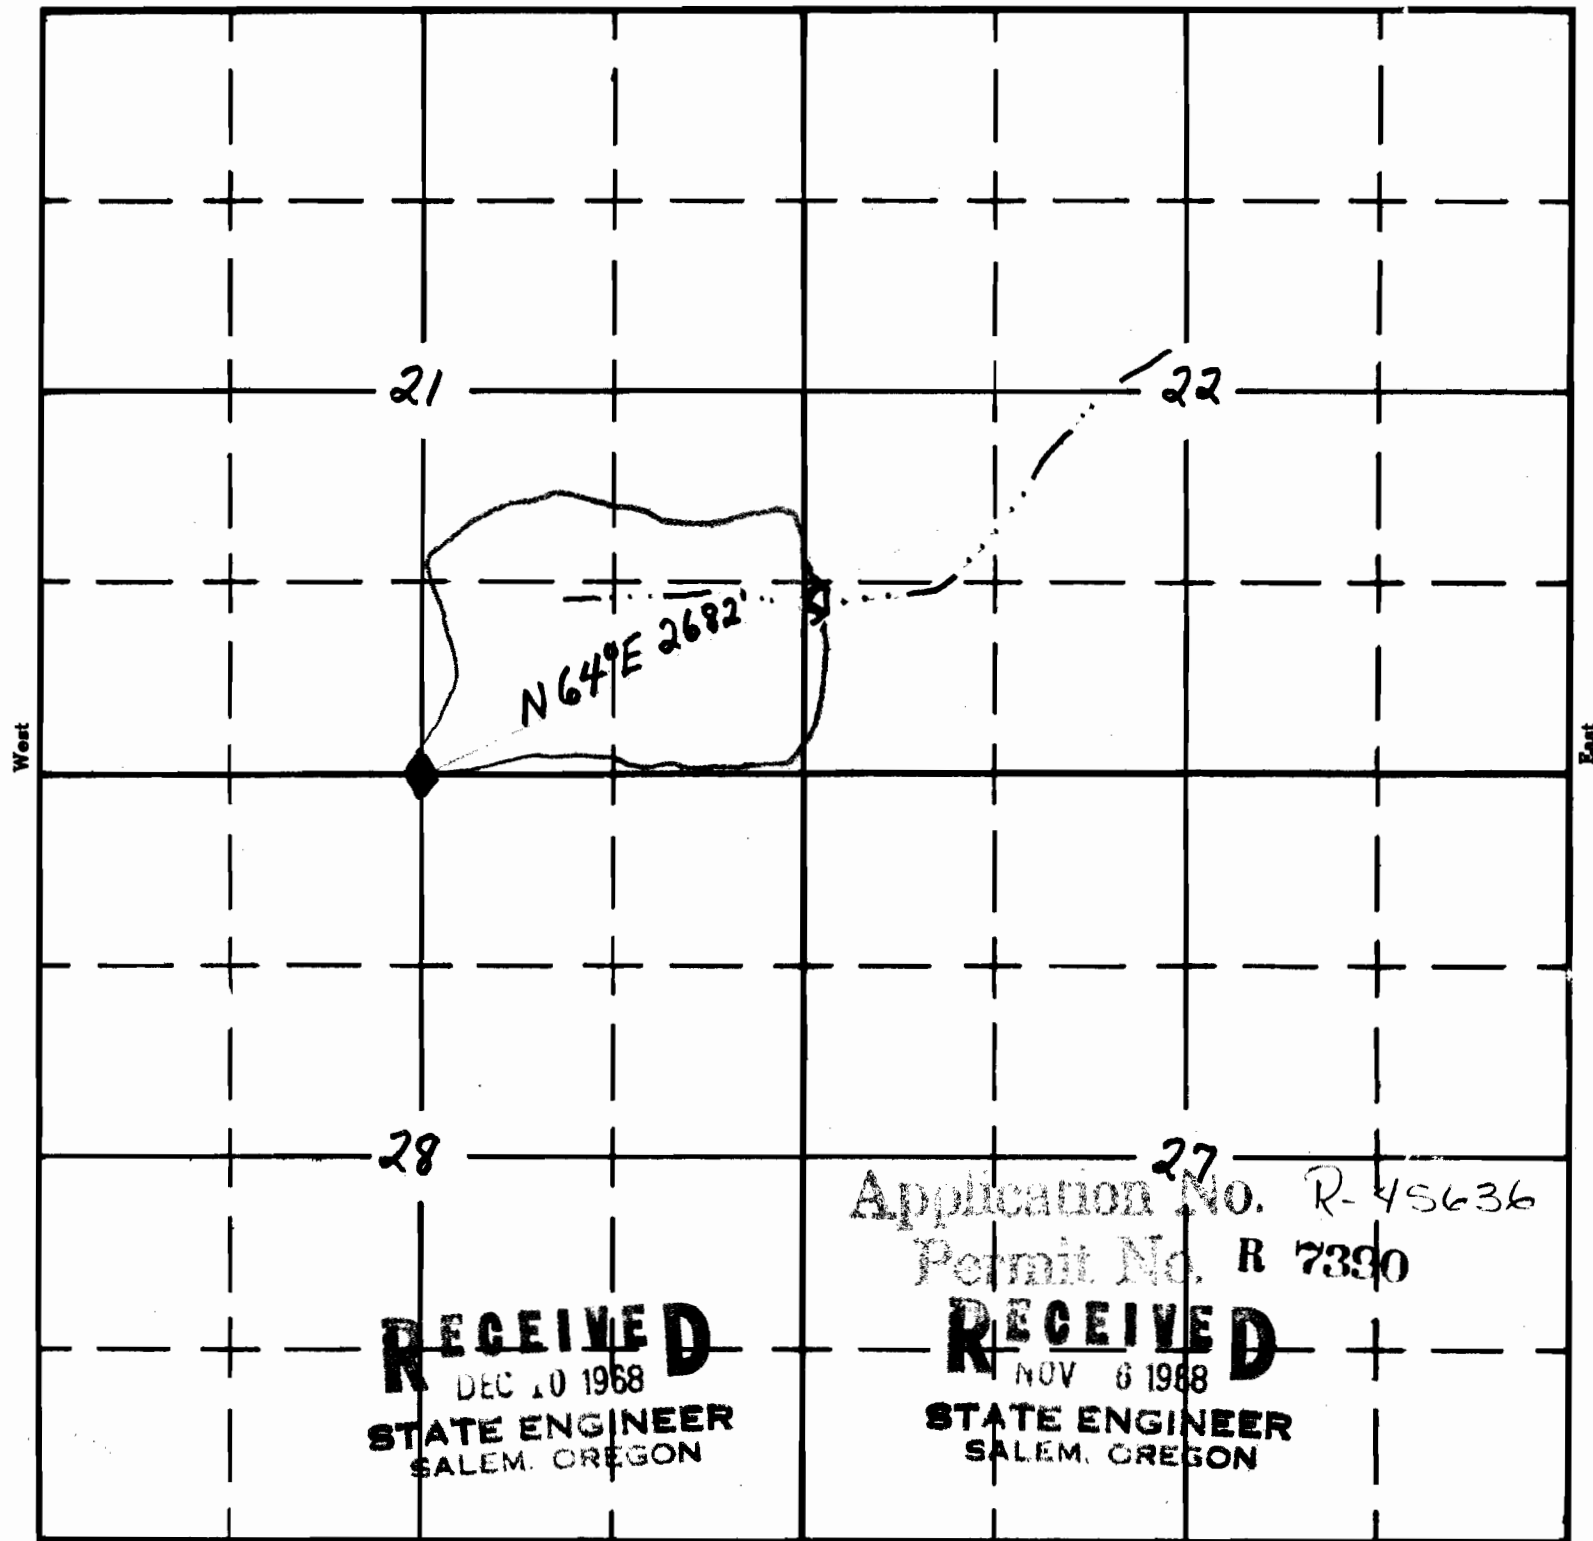

——— Watershed boundary

APPLICATION No.
PERMIT No.