

Form A1-187  
March 1961

UNITED STATES  
DEPARTMENT OF THE INTERIOR  
BUREAU OF LAND MANAGEMENT

01-R-114 R-7394  
Dobie Detention Dam

63106


SECTION

2 SENE


TOWNSHIP 40S, RANGE 14E, W. M.

*Miller Crk. & Misc.*

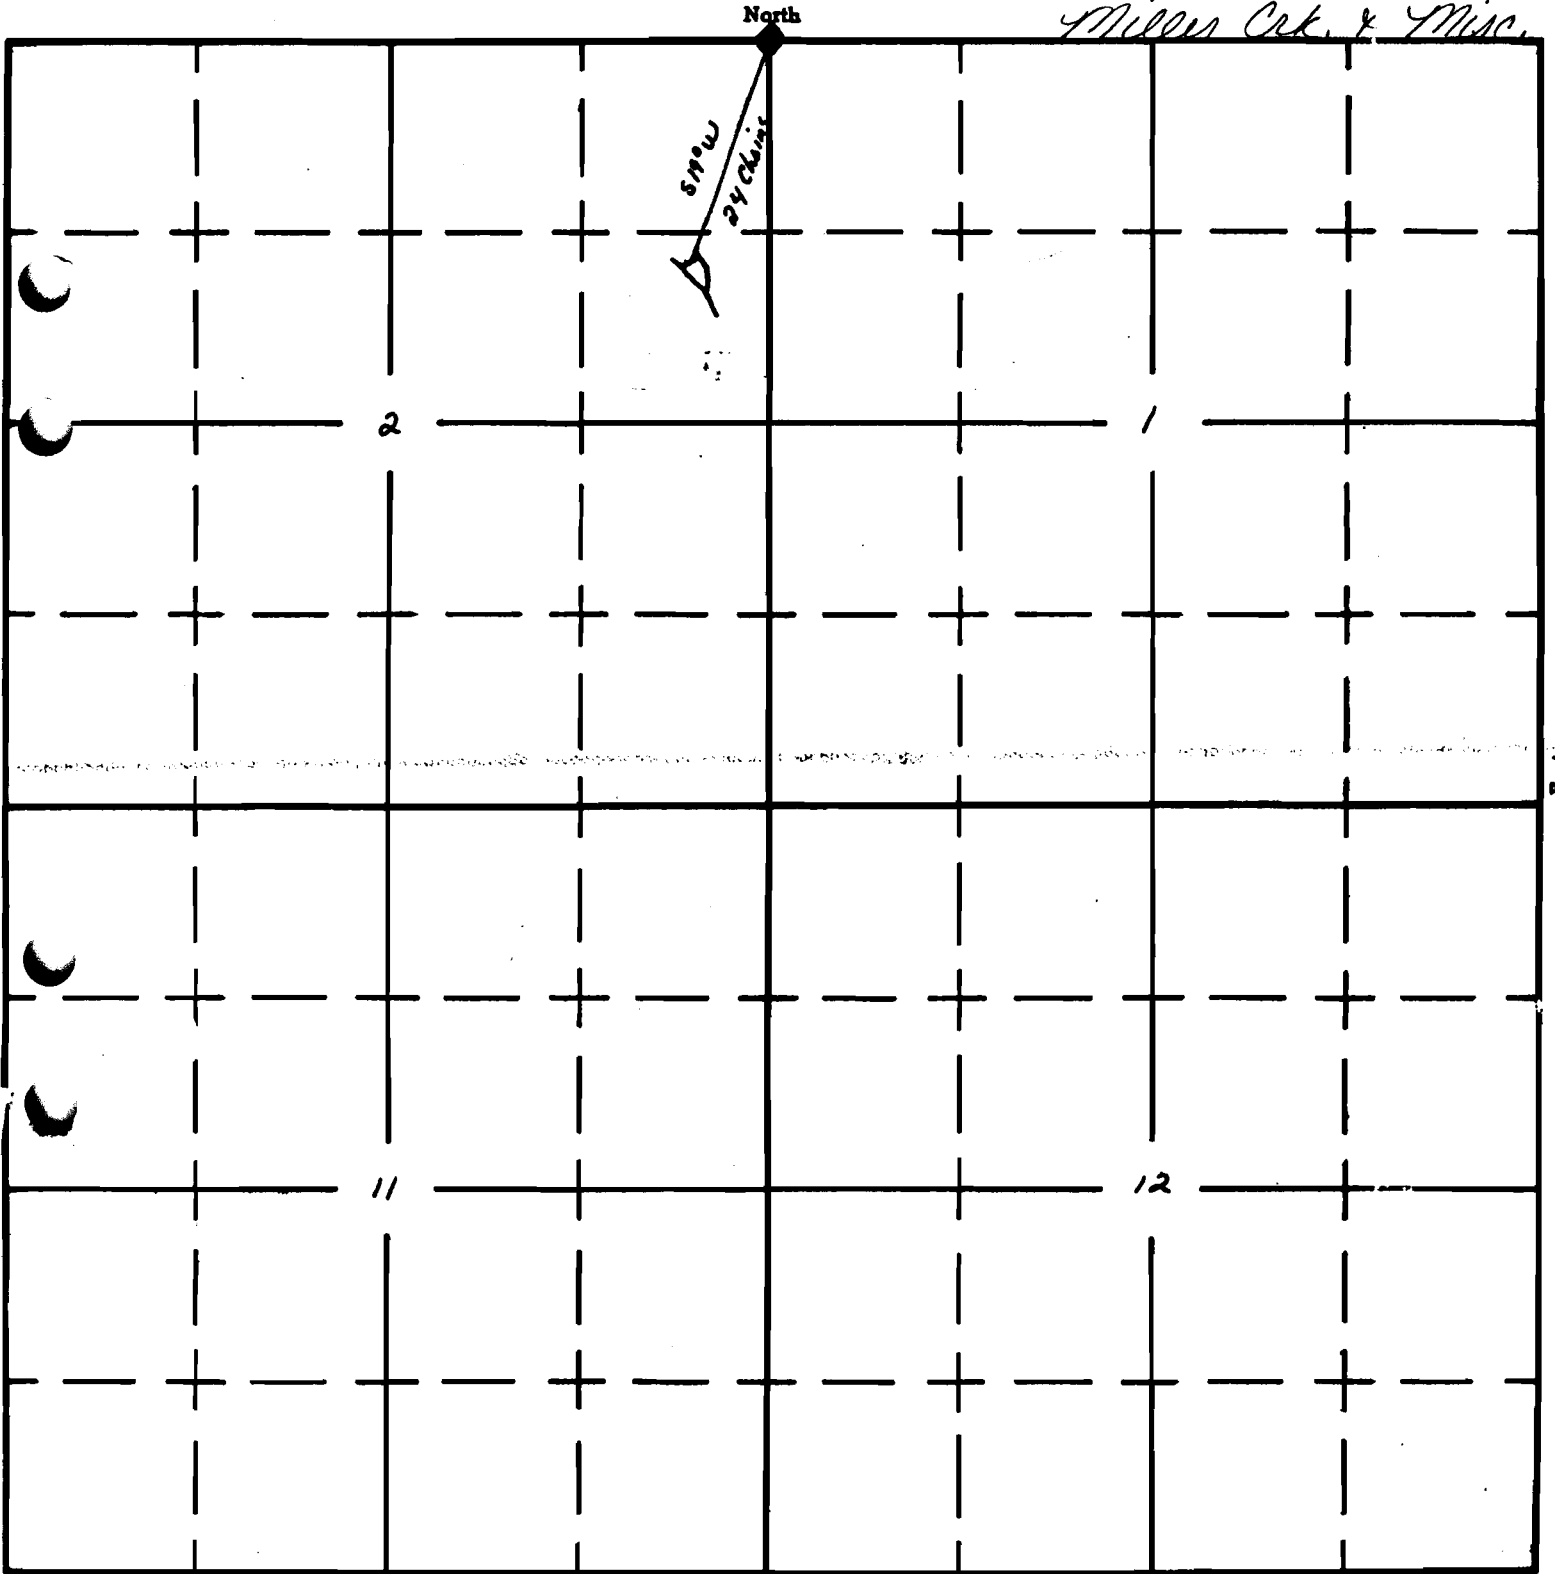

◆ Found Survey Corner

◊ Reservoir

South

APPLICATION No. 37202  
PERMIT No. R 7394