

-7114-1
Nov. 1965

UNITED STATES
DEPARTMENT OF THE INTERIOR
BUREAU OF LAND MANAGEMENT

R-7399
63107

SECTION


15
16
21
22

Oregon State Water Filings

TOWNSHIP 41s, RANGE 14E, W. M.

North

Lost River & Misc.

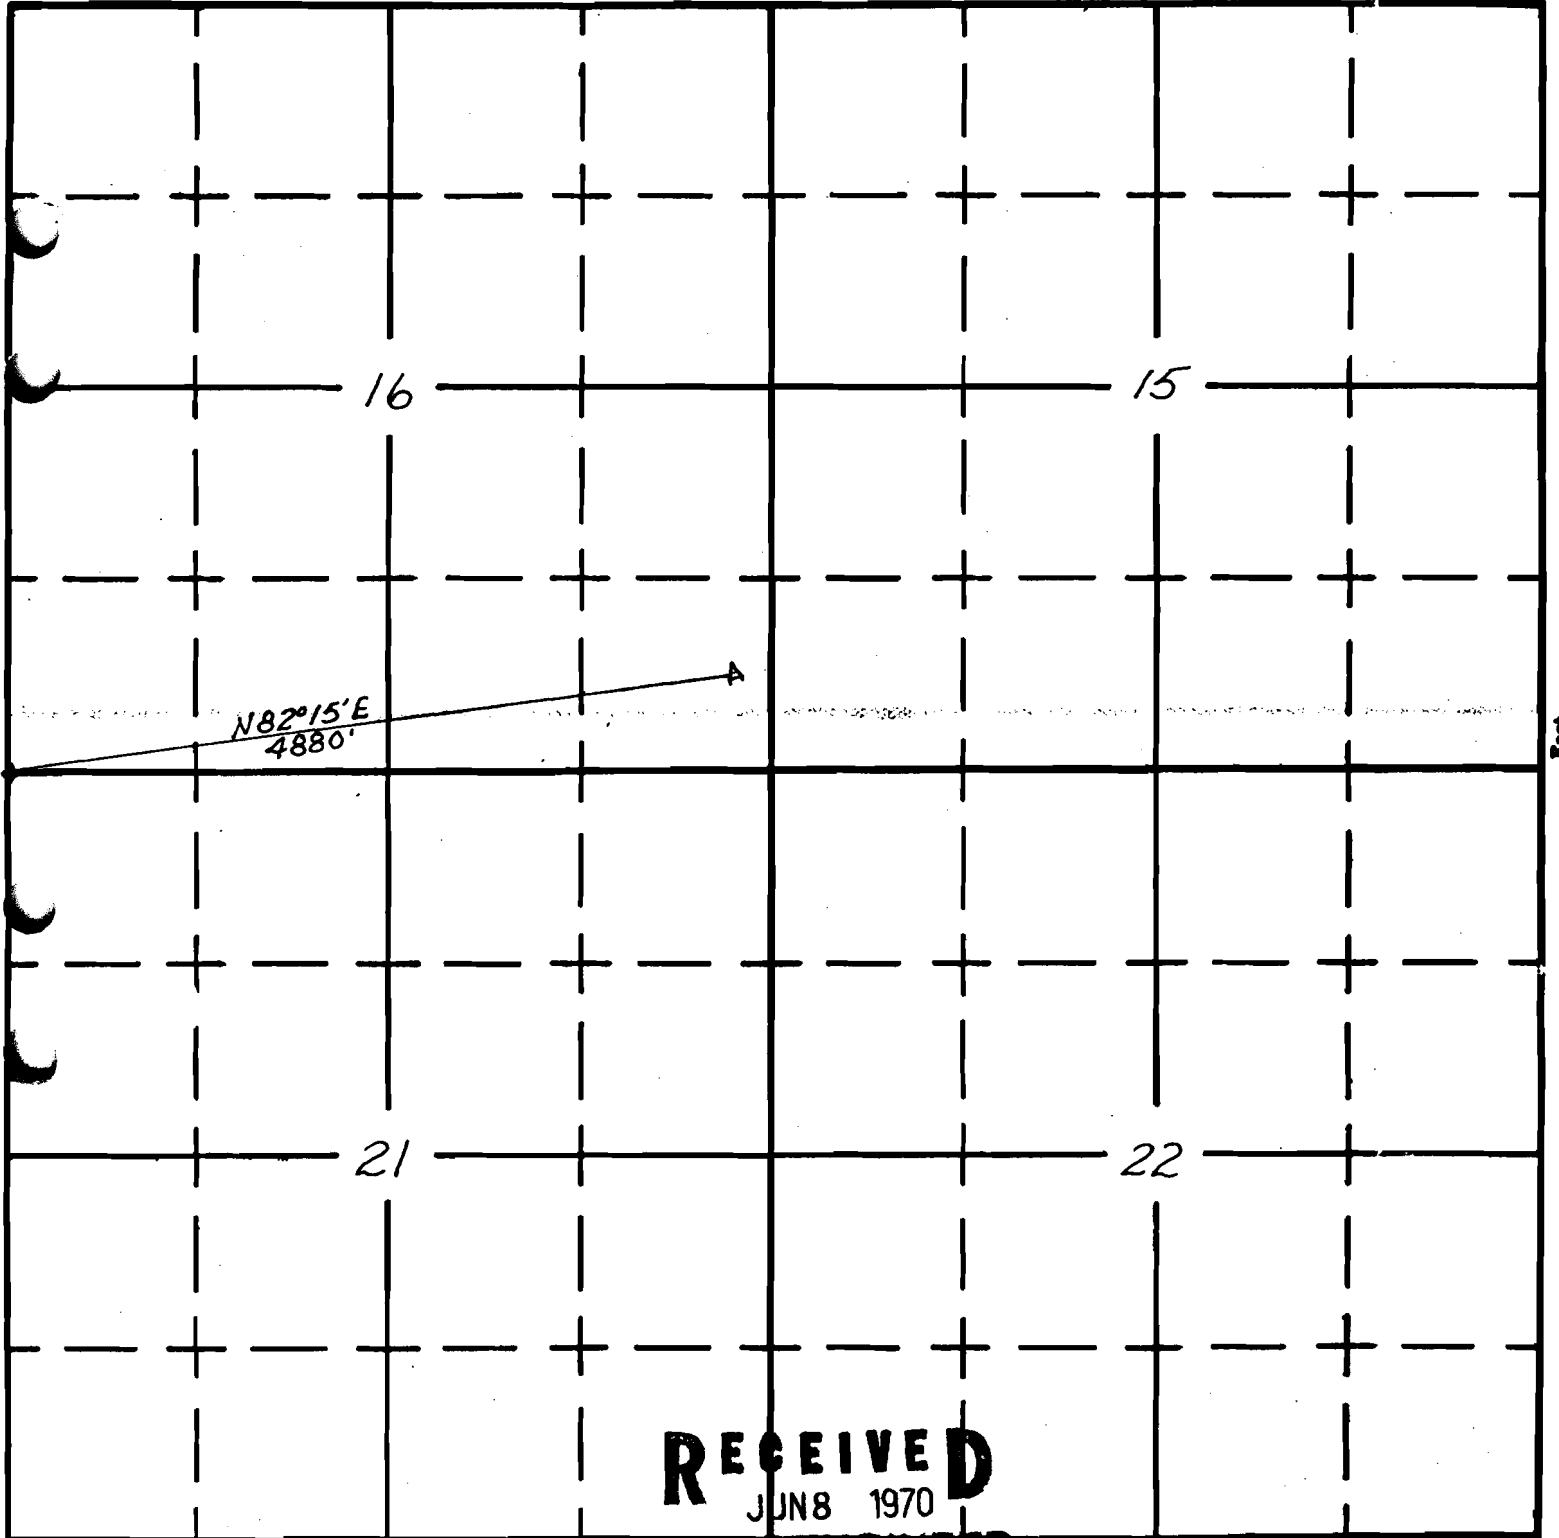

RECEIVED
JUN 8 1970

STATE ENGINEER
SALEM, OREGON

APPLICATION No. R470574
PERMIT No. 7399