

UNITED STATES  
DEPARTMENT OF THE INTERIOR  
BUREAU OF LAND MANAGEMENT


SECTION

Oregon State Water Filings

33

TOWNSHIP 17S, RANGE 38E, W. M.

*Big Lost Reservoir* North

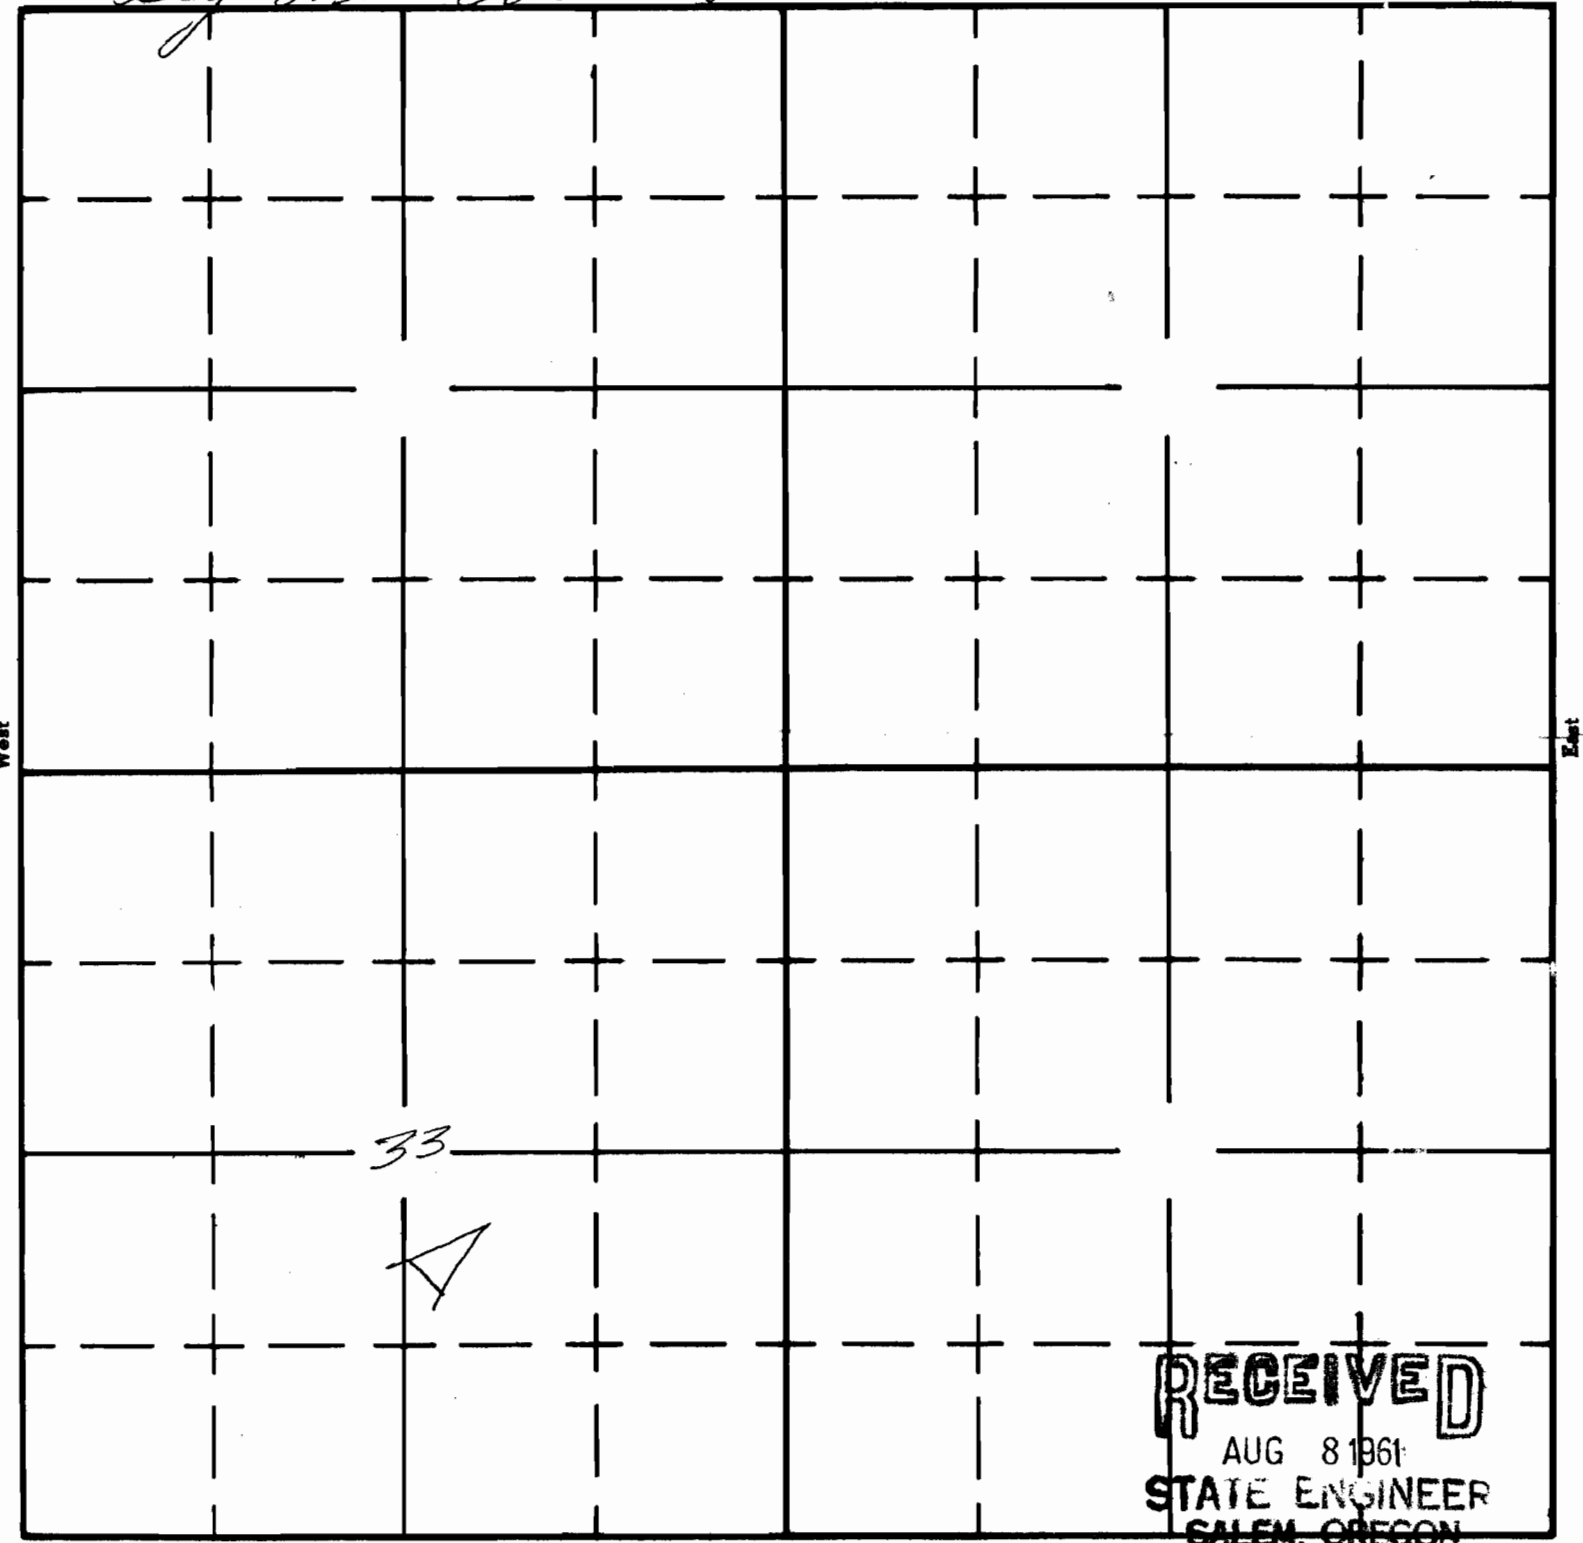

RECEIVED  
AUG 8 1961  
STATE ENGINEER  
SALEM, OREGON

APPLICATION No. *R-36860*  
PERMIT No. *7407*