

UNITED STATES
DEPARTMENT OF THE INTERIOR
BUREAU OF LAND MANAGEMENT

SECTION 22


Oregon State Water Filings

NE 1/4 NW 1/4

TOWNSHIP 24 S, RANGE 46 E, W. M.

SCALE 8" = 1 MI.

North

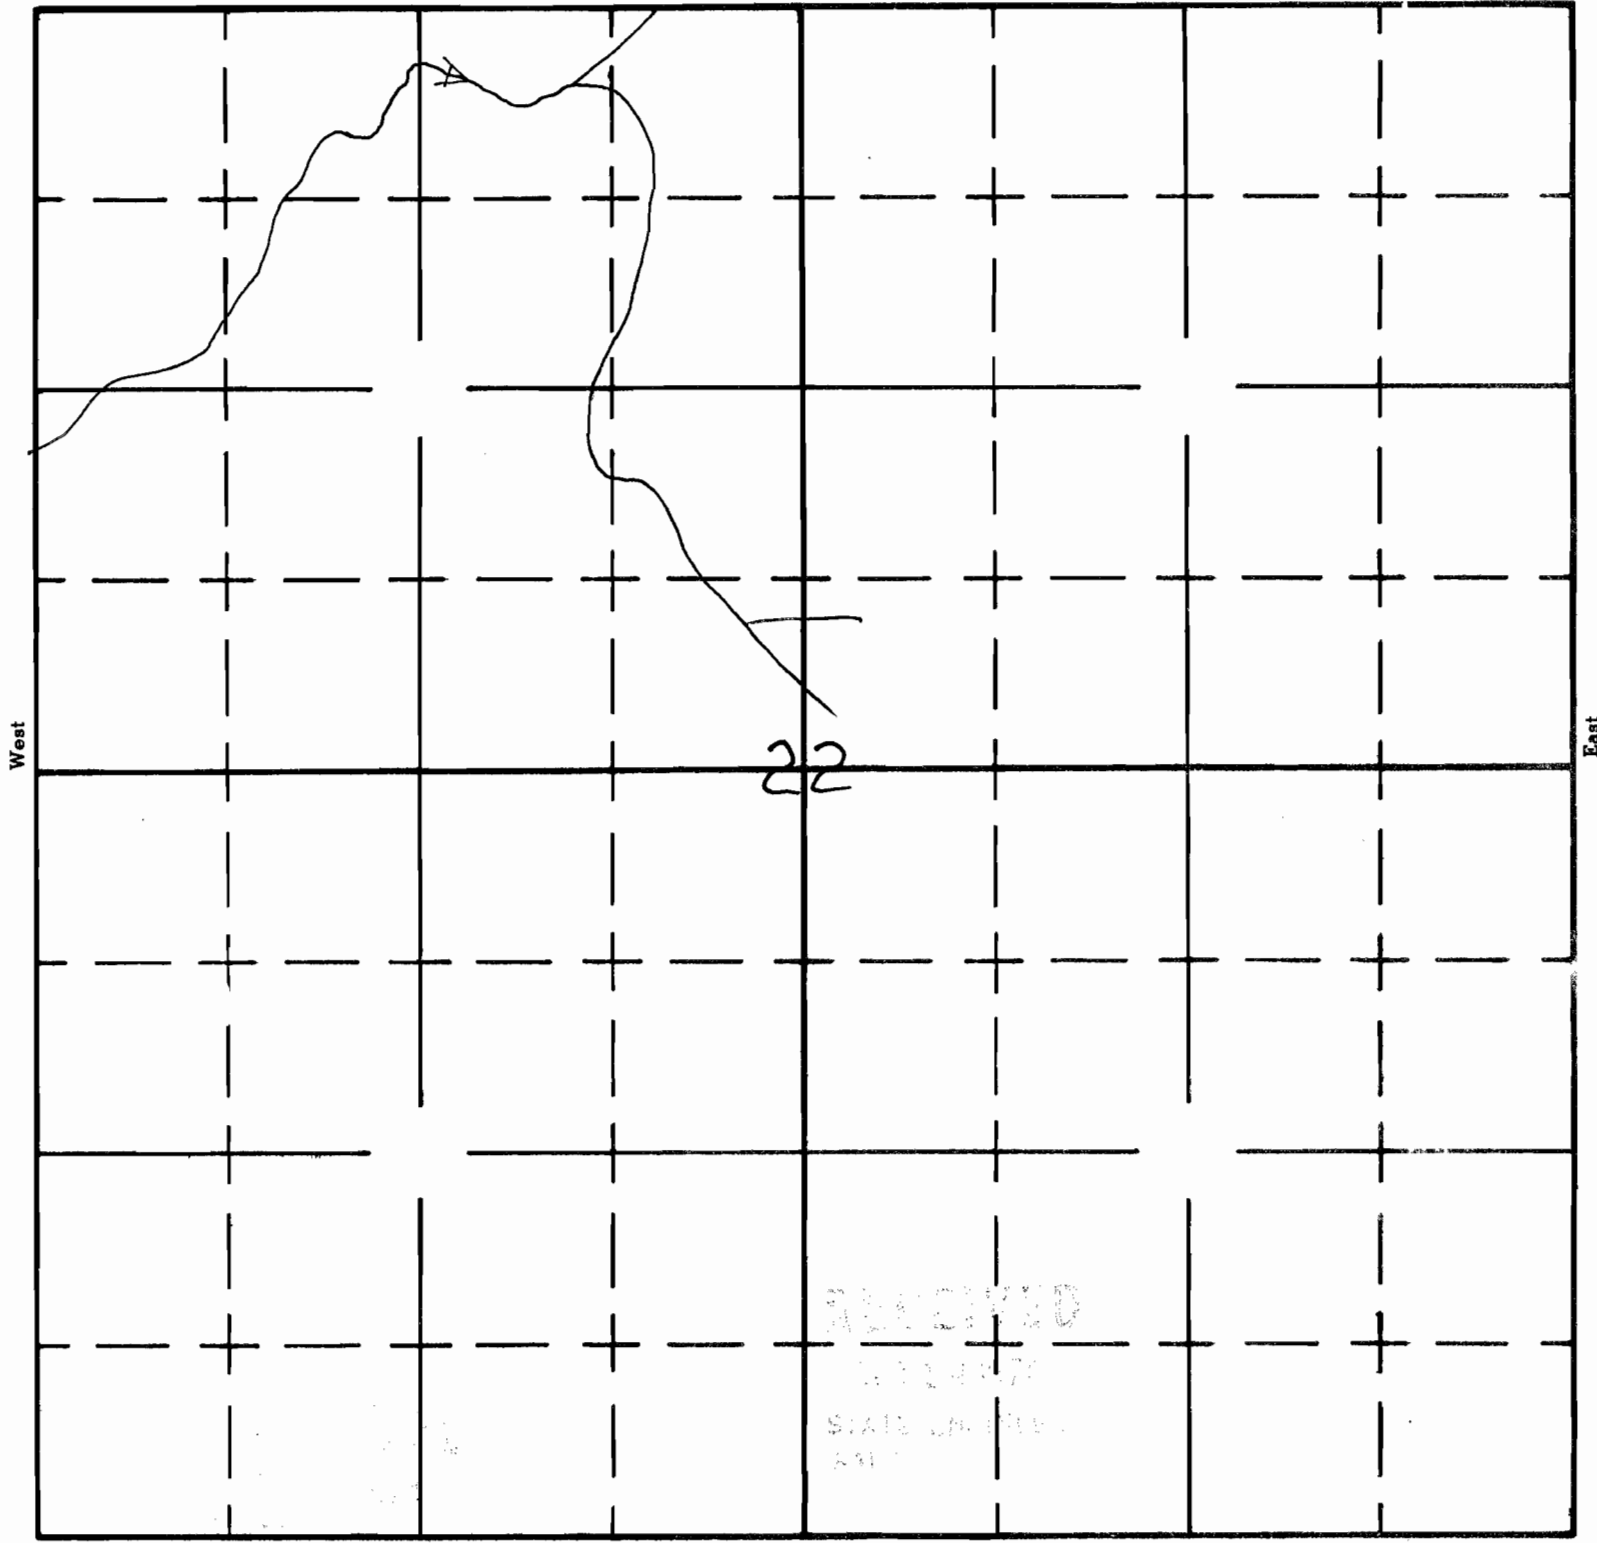

22

RECEIVED
MAY 24 1977
STATE LAND DIV.
ASST.

South

APPLICATION No. R-52295

PERMIT No. 7510