


P-5430-2
Nov. 1964

0200

UNITED STATES
DEPARTMENT OF THE INTERIOR
BUREAU OF LAND MANAGEMENT


SECTION DIAGRAM

MAP CONTRACT NO. 14-11-0001()-
T. 21 S. R. 21 E. SEC. 30, Will. MER. Prineville DISTRICT
MAPPER _____ DATE _____

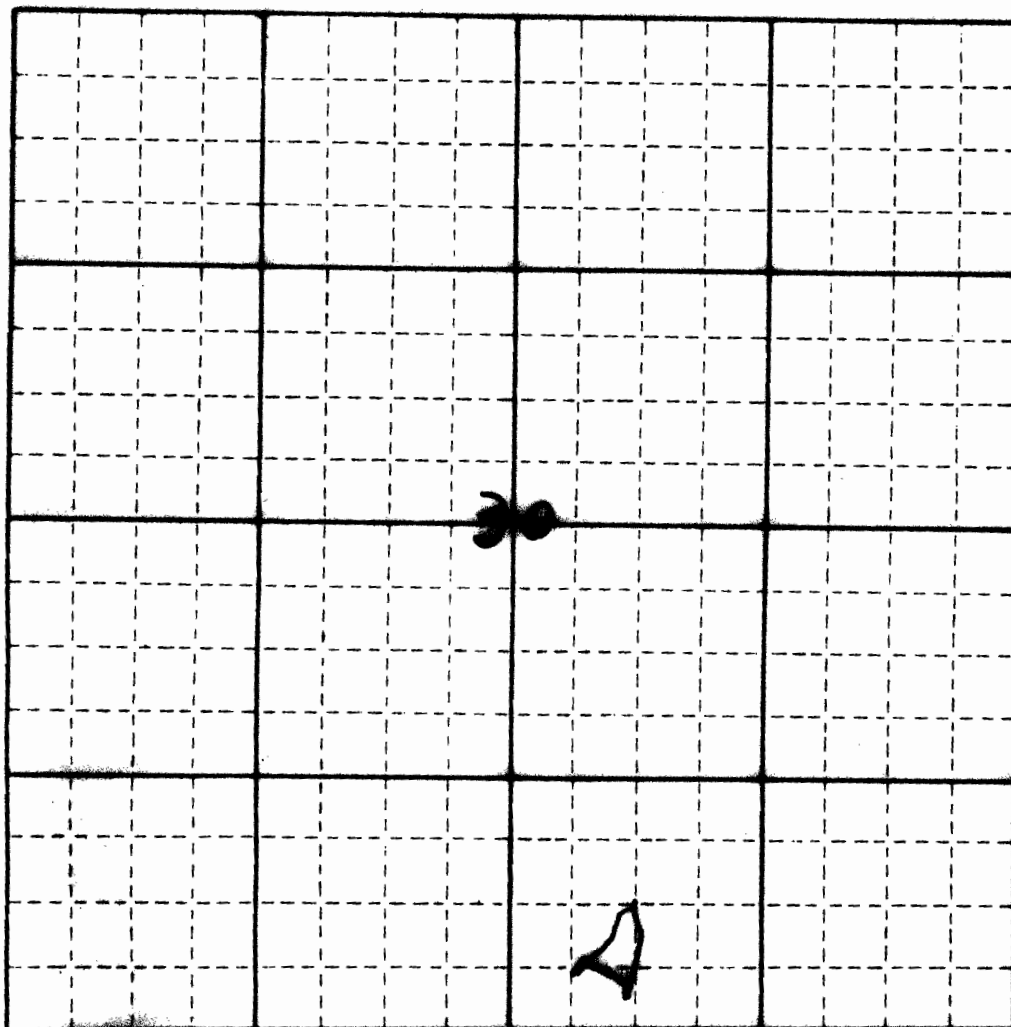

SCALE: 1" = 1,000 FT.

LEGEND

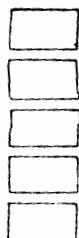

RECEIVED

NOV 14 1973

STATE ENGINEER
SALEM, OREGON

- MAINLINE ROAD
- PROPOSED SPUR ROADS
- YARDING ROADS (CAT OR HIGH LEAD)
- SPUR TREES (YARDING OR LOADING)
- CORNERS FOUND
- BOUNDARY - CONTRACT AREA
- BOUNDARY - CUTTING AREA