


P-5430-2

Nov. 1964

UNITED STATES
DEPARTMENT OF THE INTERIOR
BUREAU OF LAND MANAGEMENT

SECTION DIAGRAM

MAP CONTRACT NO. 14-11-0001()-
T. 22 S. R. 21 E. SEC. 12, Will. MER. Prineville DISTRICT
MAPPER _____ DATE _____

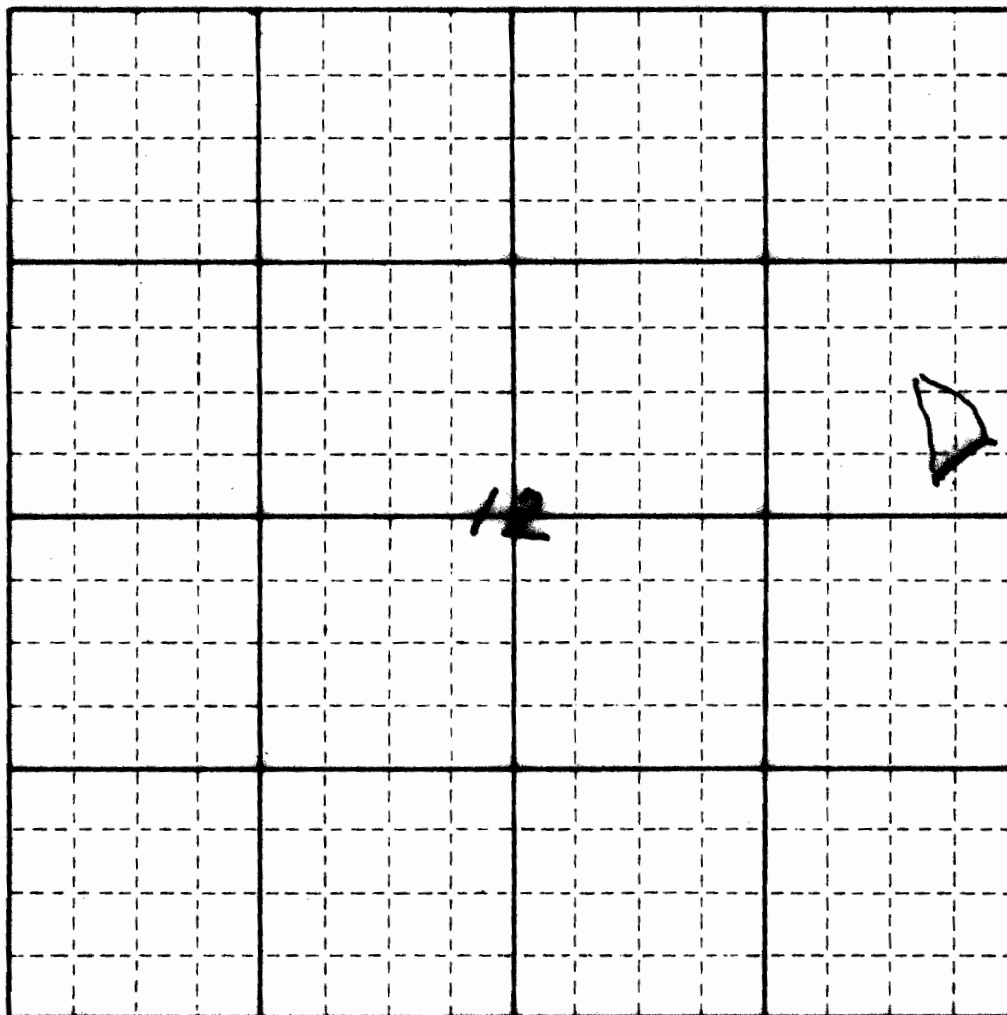

SCALE: 1" = 1,000 FT.

LEGEND

	MAINLINE ROAD
	PROPOSED SPUR ROADS
	YARDING ROADS (CAT OR HIGH LEAD)
	SPUR TREES (YARDING OR LOADING)
	CORNERS FOUND
	BOUNDARY - CONTRACT AREA
	BOUNDARY - CUTTING AREA

RECEIVED

NOV 14 1973

STATE ENGINEER
SALEM, OREGON

Application No. R-51403
Permit No. 7532