


P-5430-2
Nov. 1964

UNITED STATES
DEPARTMENT OF THE INTERIOR
BUREAU OF LAND MANAGEMENT

SECTION DIAGRAM

MAP CONTRACT No. 14-11-0001()-
T. 19 S. R. 22 E. Sec. 19, Will. Mer. Prineville DISTRICT
MAPPER _____ DATE _____

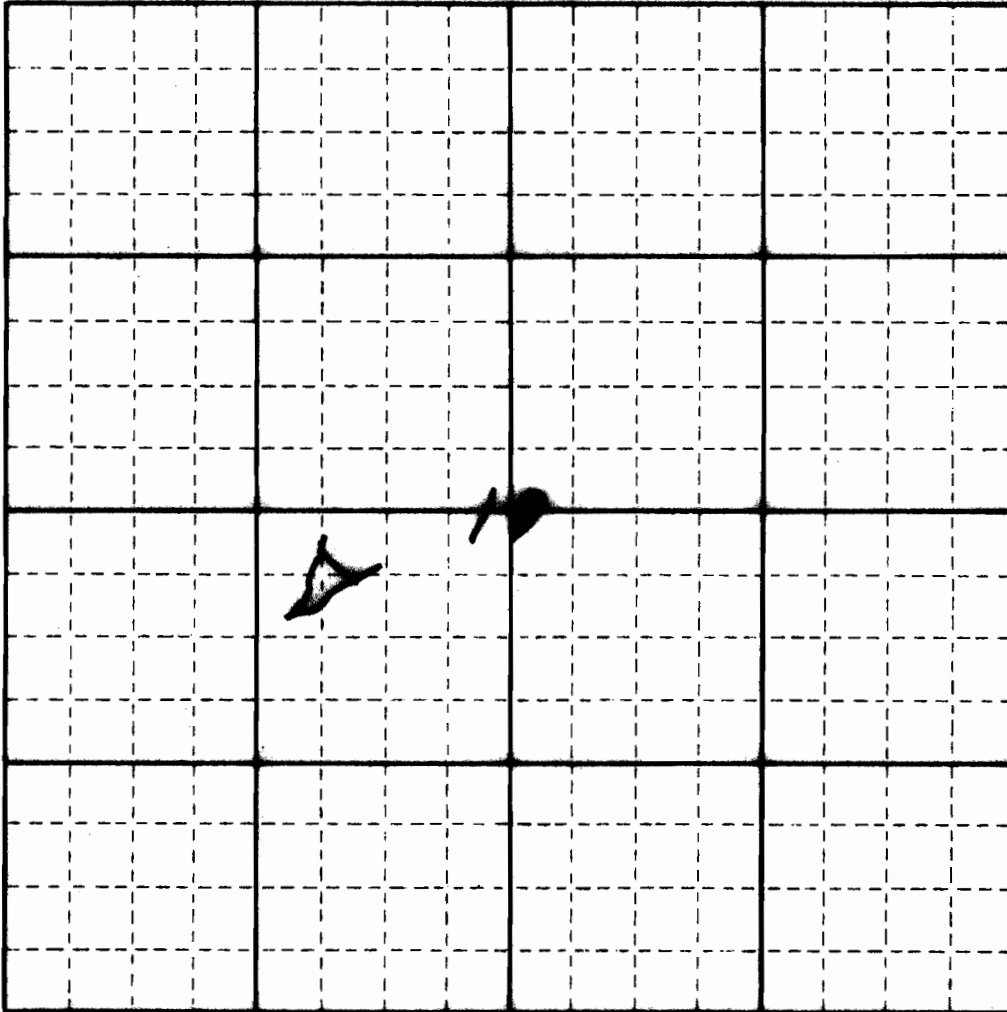

SCALE: 1" = 1,000 FT.

LEGEND

Application No. R-51410
Permit No. 7330

RECEIVED

NOV 14 1973

STATE ENGINEER
SALEM, OREGON

=====

MAINLINE ROAD

=====

PROPOSED SPUR ROADS

oooooo

YARDING ROADS (CAT OR HIGH LEAD)

●

SPUR TREES (YARDING OR LOADING)

●

CORNERS FOUND

BOUNDARY - CONTRACT AREA

=====

BOUNDARY - CUTTING AREA