


P-5430-2
Nov. 1964

UNITED STATES
DEPARTMENT OF THE INTERIOR
BUREAU OF LAND MANAGEMENT


SECTION DIAGRAM

MAP CONTRACT No. 14-11-0001()-
T. 19 S. R. 15 E. SEC. 2, Will. MER. Prineville DISTRICT
MAPPER _____ DATE _____

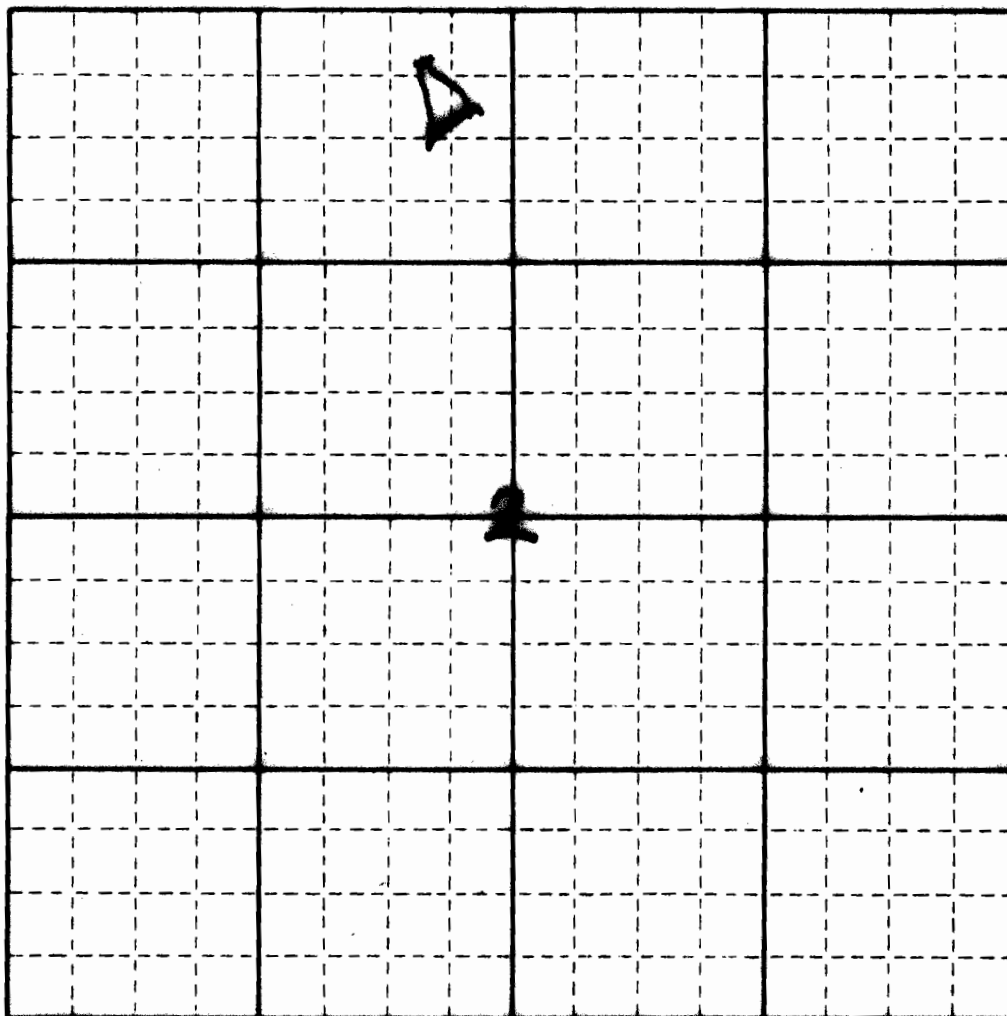

SCALE: 1" = 1,000 FT.

LEGEND

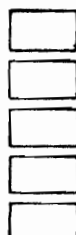

RECEIVED

NOV 14 1973

STATE ENGINEER
SALEM, OREGON

- ===== MAINLINE ROAD
- PROPOSED SPUR ROADS
- ooooooo YARDING ROADS (CAT OR HIGH LEAD)
- ⊙ SPAR TREES (YARDING OR LOADING)
- CORNERS FOUND
- BOUNDARY - CONTRACT AREA
- BOUNDARY - CUTTING AREA

Application No. R-51414
Permit No. R-75418