


UNITED STATES
DEPARTMENT OF THE INTERIOR
BUREAU OF LAND MANAGEMENT

0339

SECTION DIAGRAM


MAP CONTRACT No. 14-11-0001()-
T. 19 S. R. 16 E. SEC. 3, Will. MER. Prineville DISTRICT
MAPPER _____ DATE _____

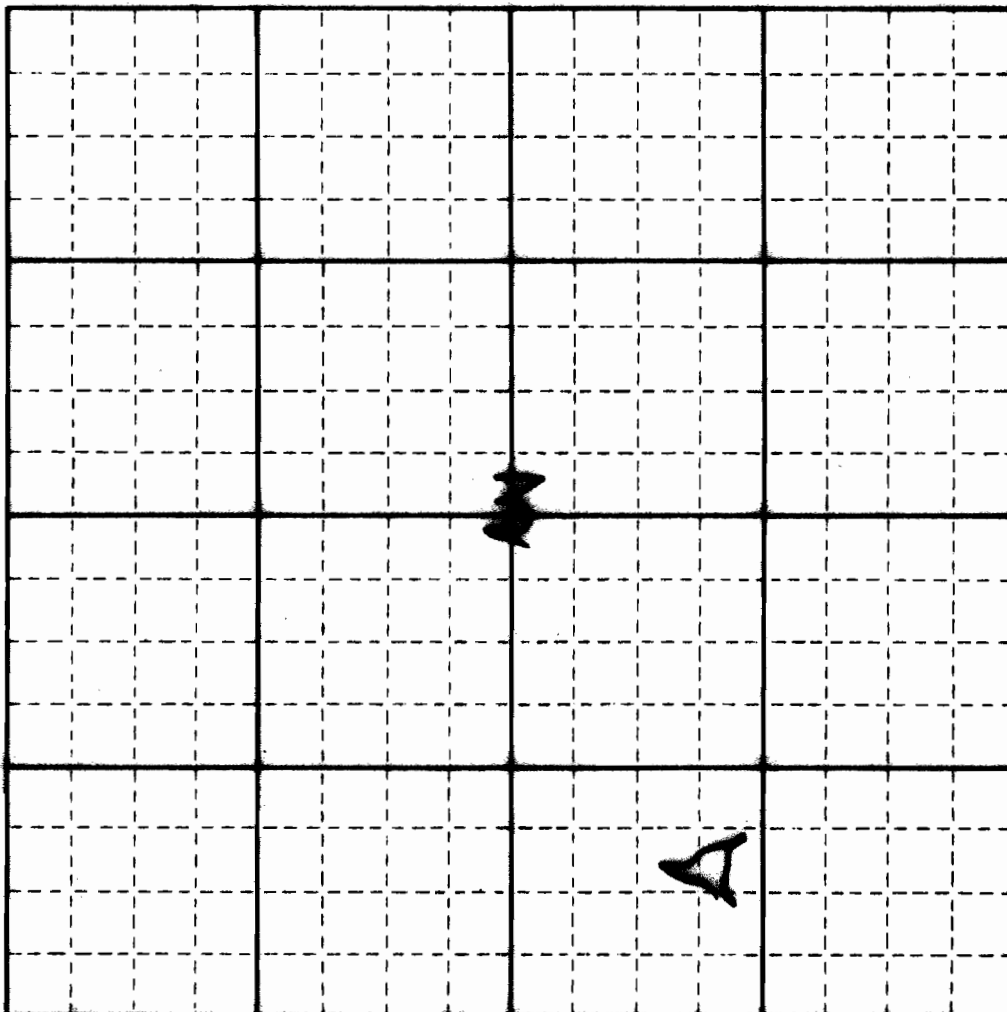

Application N
Permit N
R-5146
R 7514

SCALE: 1" = 1,000 FT.

LEGEND

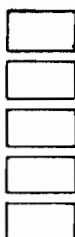

RECEIVED

NOV 14 1973

STATE ENGINEER
SALEM, OREGON



MAINLINE ROAD



PROPOSED SPUR ROADS



YARDING ROADS (CAT OR HIGH LEAD)



SPAR TREES (YARDING OR LOADING)



CORNERS FOUND



BOUNDARY - CONTRACT AREA



BOUNDARY - CUTTING AREA