


P-5430-2
Nov. 1964

UNITED STATES
DEPARTMENT OF THE INTERIOR
BUREAU OF LAND MANAGEMENT


SECTION DIAGRAM

MAP CONTRACT NO. 14-11-0001()-
T. 20 S. R. 22 E. SEC. 8, Will. MER. Prineville DISTRICT
MAPPER _____ DATE _____

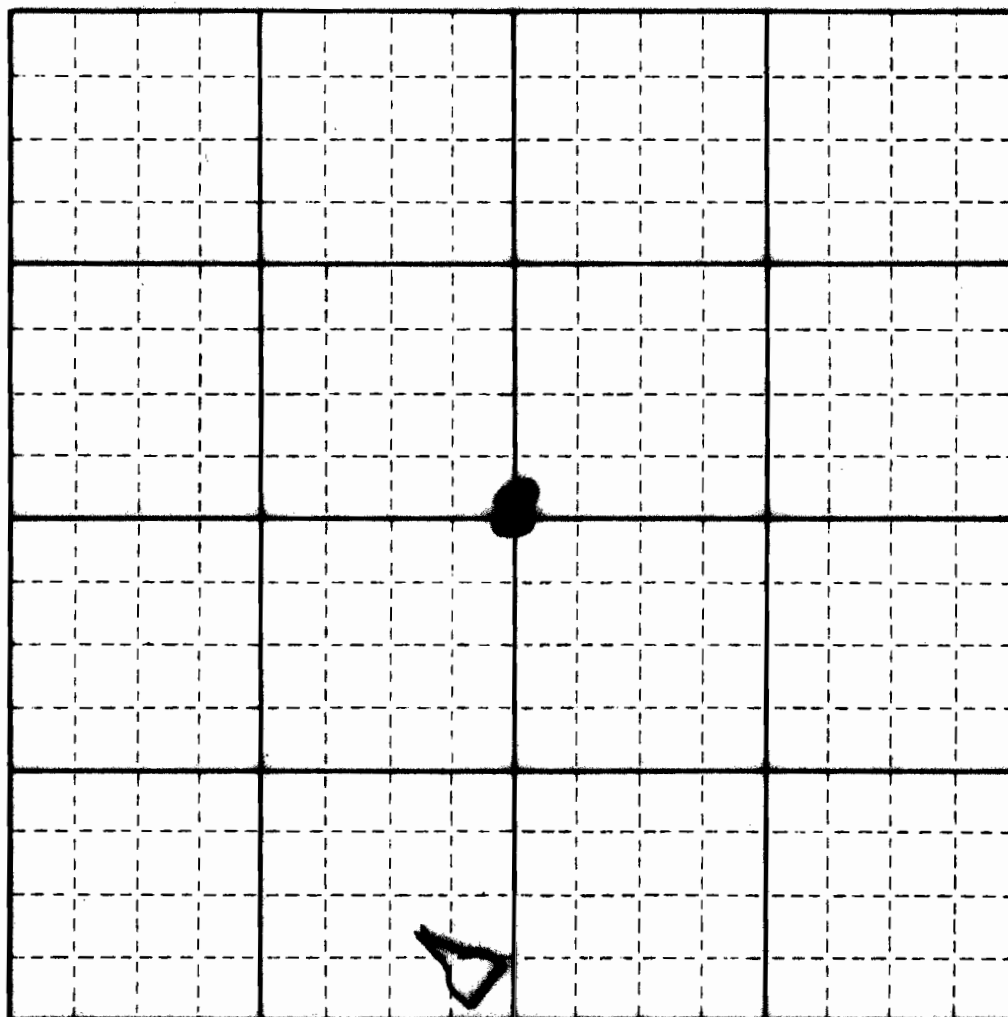

SCALE: 1" = 1,000 FT.

LEGEND

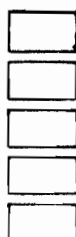



MAINLINE ROAD



PROPOSED SPUR ROADS



YARDING ROADS (CAT OR HIGH LEAD)



SPUR TREES (YARDING OR LOADING)



CORNERS FOUND



BOUNDARY - CONTRACT AREA



BOUNDARY - CUTTING AREA

RECEIVED

NOV 14 1973

STATE ENGINEER
SALEM, OREGON

Application No. R-51435
Permit N. R. 7551