


P-5430-2
Nov. 1964

UNITED STATES
DEPARTMENT OF THE INTERIOR
BUREAU OF LAND MANAGEMENT

SECTION DIAGRAM

MAP CONTRACT NO. 14-11-0001()-
T. 16 S. R. 25 E. SEC. 34, WillMER. Prineville DISTRICT
MAPPER _____ DATE _____

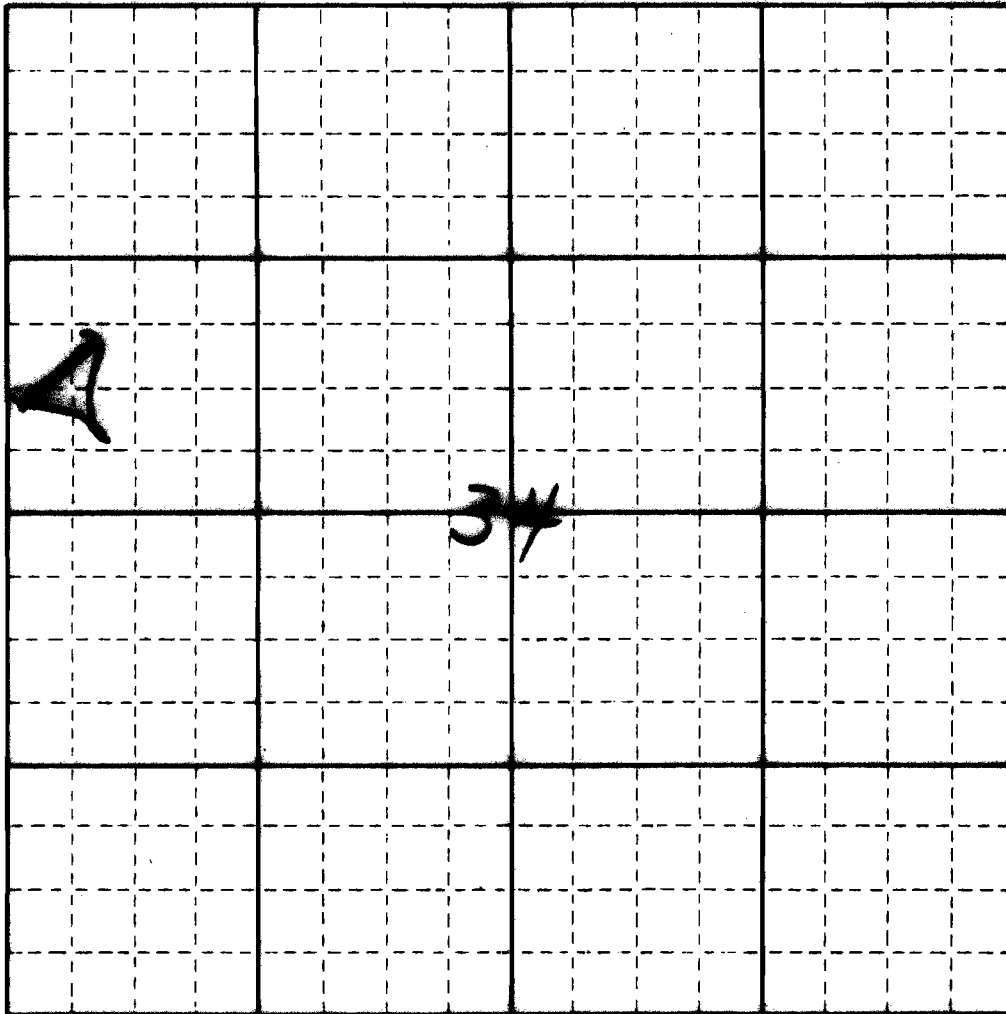

SCALE: 1" = 1,000 FT.

LEGEND

Application No. 6-5737
Permit No. 67554

RECEIVED

NOV 14 1973

STATE ENGINEER
SALEM, OREGON

- ===== MAINLINE ROAD
- PROPOSED SPUR ROADS
- oooooo YARDING ROADS (CAT OR HIGH LEAD)
- SPUR TREES (YARDING OR LOADING)
- CORNERS FOUND
- BOUNDARY - CONTRACT AREA
- BOUNDARY - CUTTING AREA