


P-5430-2
Nov. 1964

UNITED STATES
DEPARTMENT OF THE INTERIOR
BUREAU OF LAND MANAGEMENT

0573

SECTION DIAGRAM

MAP CONTRACT No. 14-11-0001()-
T. 20 S. R. 23 E. SEC. 36, Will. MER. Prineville DISTRICT
MAPPER _____ DATE _____

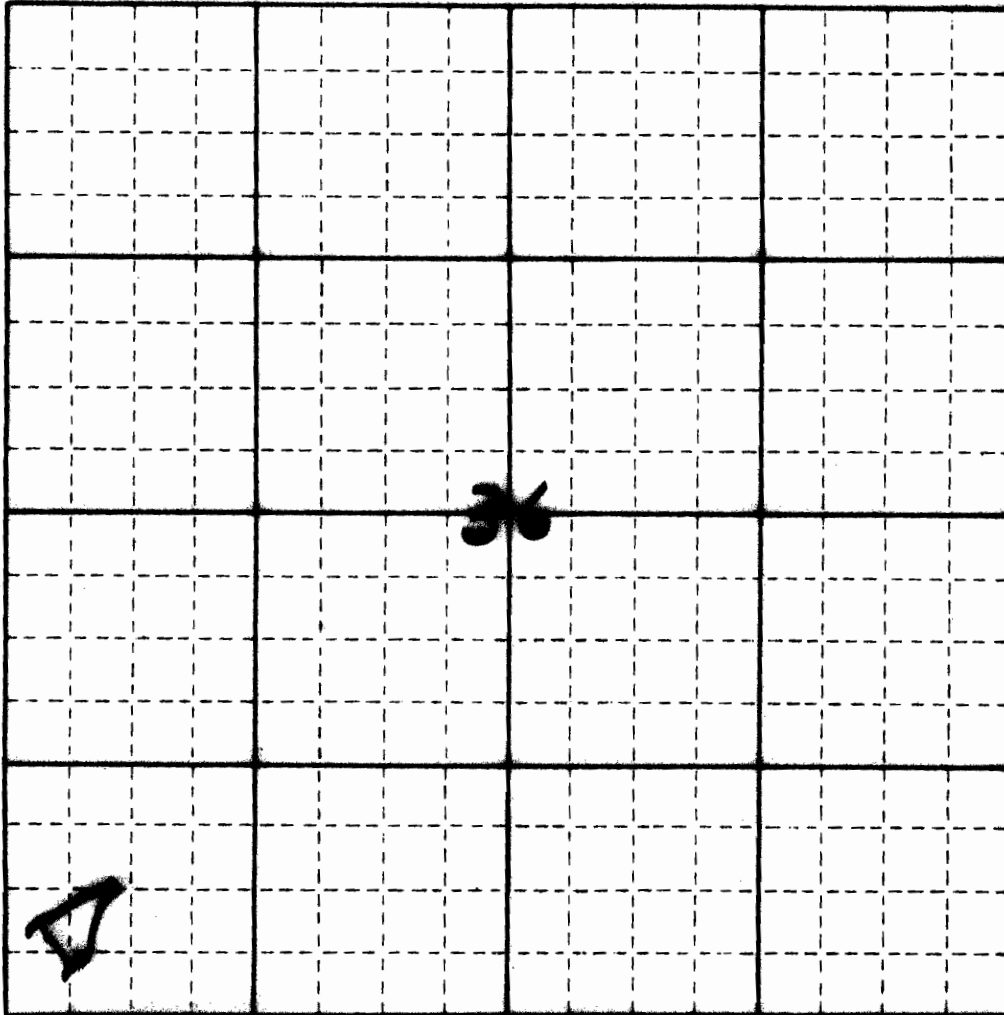

Application No. R-51445
Parcel No. R-51445

SCALE: 1" = 1,000 FT.

LEGEND

Five empty rectangular boxes for stamping.

RECEIVED

NOV 14 1973

STATE ENGINEER
SALEM, OREGON

- MAINLINE ROAD
- PROPOSED SPUR ROADS
- YARDING ROADS (CAT OR HIGH LEAD)
- SPUR TREES (YARDING OR LOADING)
- CORNERS FOUND
- BOUNDARY - CONTRACT AREA
- BOUNDARY - CUTTING AREA