


P-5430-2  
Nov. 1964

UNITED STATES  
DEPARTMENT OF THE INTERIOR  
BUREAU OF LAND MANAGEMENT


SECTION DIAGRAM

MAP CONTRACT NO. 14-11-0001( )-  
T. 18 S. R. 17 E. SEC. 19 Will. MER. Prineville DISTRICT  
MAPPER \_\_\_\_\_ DATE \_\_\_\_\_

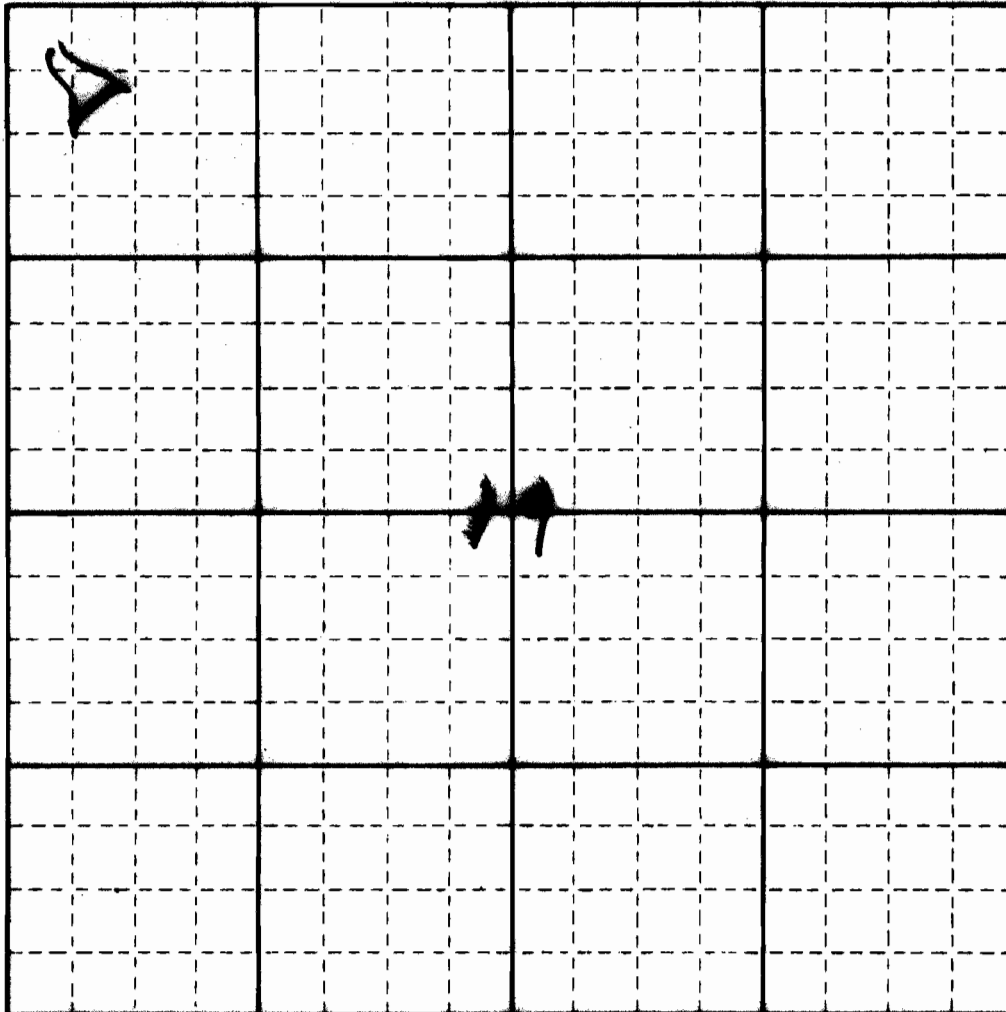

SCALE: 1" = 1,000 FT.

LEGEND

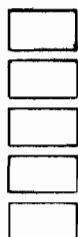

**RECEIVED**

NOV 14 1973

STATE ENGINEER  
SALEM, OREGON

- MAINLINE ROAD
- PROPOSED SPUR ROADS
- YARDING ROADS (CAT OR HIGH LEAD)
- SPUR TREES (YARDING OR LOADING)
- CORNERS FOUND
- BOUNDARY - CONTRACT AREA
- BOUNDARY - CUTTING AREA

Application No. R-51463  
Permit N F 7576