


P-5430-2
Nov. 1964

UNITED STATES
DEPARTMENT OF THE INTERIOR
BUREAU OF LAND MANAGEMENT

SECTION DIAGRAM


MAP CONTRACT NO. 14-11-0001()-
T. 16 S. R. 21 E. SEC. 30, Will. MER. Prineville DISTRICT
MAPPER _____ DATE _____

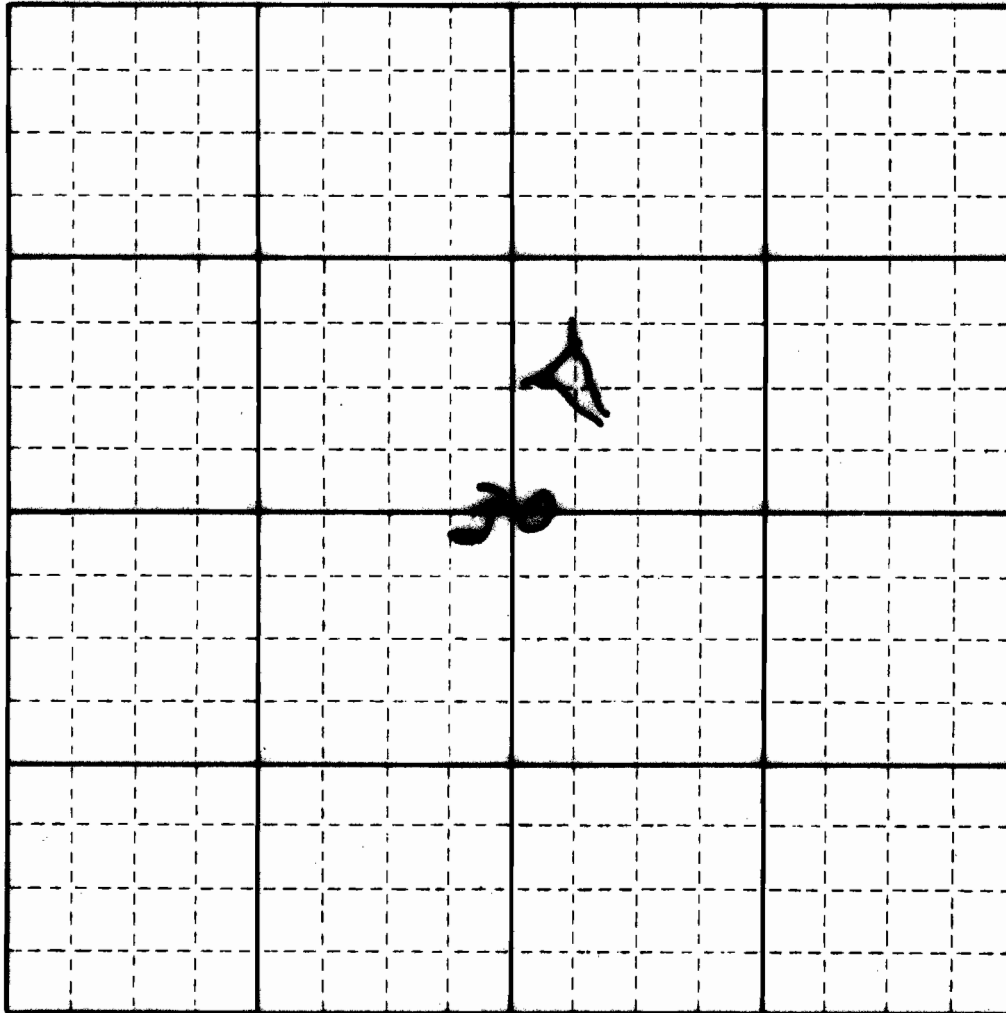

Application No. R-51464
Permit No. R 7577

SCALE: 1" = 1,000 FT.

LEGEND

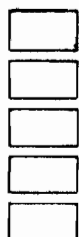

RECEIVED

NOV 14 1973

STATE ENGINEER
SALEM, OREGON



MAINLINE ROAD



PROPOSED SPUR ROADS



YARDING ROADS (CAT OR HIGH LEAD)



SPUR TREES (YARDING OR LOADING)



CORNERS FOUND



BOUNDARY - CONTRACT AREA



BOUNDARY - CUTTING AREA