


P-5430-2
Nov, 1964

UNITED STATES
DEPARTMENT OF THE INTERIOR
BUREAU OF LAND MANAGEMENT


SECTION DIAGRAM

MAP CONTRACT No. 14-11-0001()-
T. 17 S. R. 25 E. SEC. 20, Will MER. Prineville DISTRICT
MAPPER _____ DATE _____

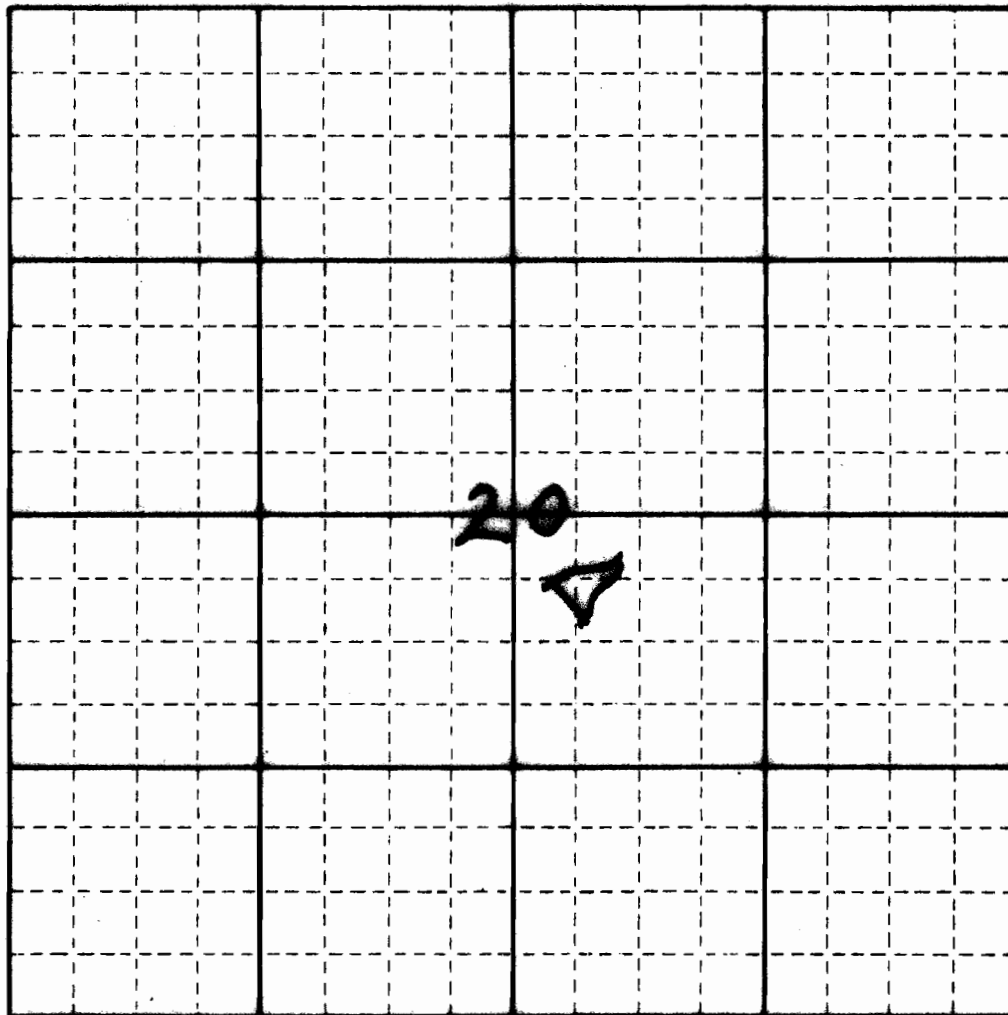

SCALE: 1" = 1,000 FT.

LEGEND

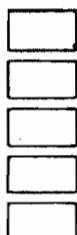

RECEIVED

NOV 14 1973

STATE ENGINEER
SALEM, OREGON



MAINLINE ROAD



PROPOSED SPUR ROADS



YARDING ROADS (CAT OR HIGH LEAD)



SPAR TREES (YARDING OR LOADING)



CORNERS FOUND



BOUNDARY - CONTRACT AREA



BOUNDARY - CUTTING AREA