


P-5430-2
Nov. 1964

UNITED STATES
DEPARTMENT OF THE INTERIOR
BUREAU OF LAND MANAGEMENT

SECTION DIAGRAM

MAP CONTRACT NO. 14-11-0001()-
T. 21 S. R. 23 E. SEC. 15, Will. MER. Prineville DISTRICT
MAPPER _____ DATE _____

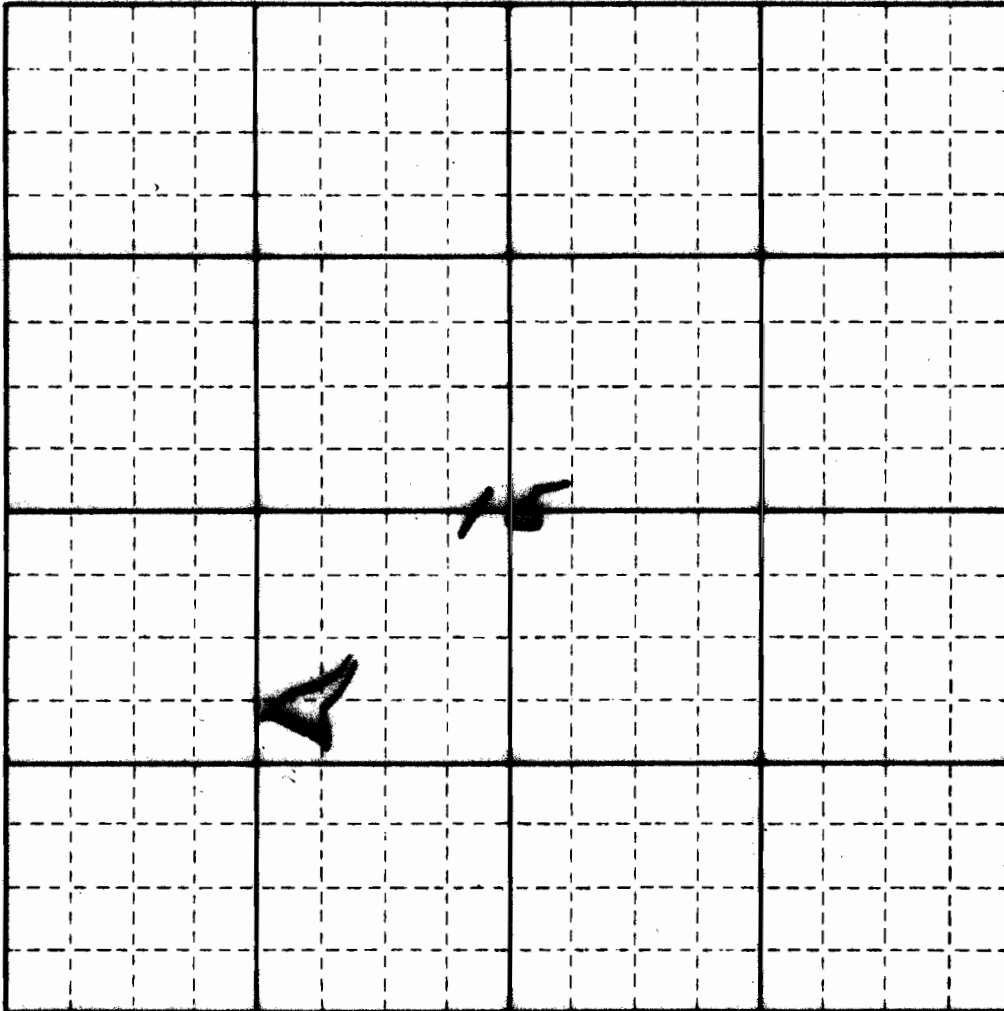


SCALE: 1" = 1,000 FT.

LEGEND

RECEIVED

NOV 14 1973

STATE ENGINEER
SALEM, OREGON

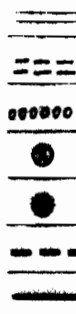

MAINLINE ROAD

PROPOSED SPUR ROADS

YARDING ROADS (CAT OR HIGH LEAD)

SPAR TREES (YARDING OR LOADING)

CORNERS FOUND

BOUNDARY - CONTRACT AREA

BOUNDARY - CUTTING AREA

Application No. R-51465
Permit No. R 7595